

U.S. PUBLIC LAND SURVEY MONUMENT RECORD

For Public Land Survey Corners in:

WI ADMINISTRATIVE CODE A-E 7.08 REQUIREMENT

T. 2 N., R. 11 E

CORNER CODE INDEX

A	1	2	3	4	5	6	7	8	9	10	11	12	13	14	15	16	17	18	19	20	21	22	23	24	25
B																									
C	6					5					A			3				2						1	
D																									
E																									
F	1					8					9			10				11						12	
G																									
H																									
J																									
K	18					17					16			15				14						13	
L																									
M																									
N																									
O	19					20					21			22				23						24	
P																									
Q																									
R																									
S	30					29					28			27				26						25	
T																									
U																									
V																									
W																									
X	31					32					33			34				35						36	
Y																									
Z																									

PLYMOUTH TWP

ROCK COUNTY WI

IF AVAILABLE
ROCK COUNTY COORDINATES PREFERRED

North _____ Elev. _____

East _____

Hor. Datum _____ Vert. Datum _____

LATITUDE _____ ELLIPS. HT. _____

LONGITUDE _____

GPS (X) _____ TRAVERSE (X) _____

BASED ON THE FOLLOWING CONTROL:

PLACE MONUMENT SYMBOL AT PROPER LOCATION ON ABOVE INDEX

CORNER MONUMENT

WITNESS MONUMENT

(a)

BEARINGS ARE BASED ON:

FIELD BOOK _____ PAGE # _____

SHEET 1 OF 4

SHOW A PLAN VIEW DRAWING DEPICTING THE CORNER MONUMENT AND SURROUNDING PHYSICAL FEATURES, INCLUDING THE EXCAVATION AREA AND DEPTH.

PLANNING & ZONING COMMITTEE ADOPTED THE ABOVE FORM ON 12/2/1982

CORNER CODE R-13

PL587

(B) Describe any record evidence, monument evidence, occupational evidence, testimonial evidence or any other material evidence you considered, and whether the monument was found or placed.

- 1833 HARRISON NORTH BETWEEN 27 & 28
- 858 LEFT TIMBER & ENTER PRAIRIE
- 2640 QUARTER SEC COR. POST & RAISED MOUND
- 5280 SET POST FOR COR TO SEC 21, 22, 27, 28 ON GROUND DESCENDING N.W. SET POST &* RAISED A MOUND. LAND MOSTLY HIGH ROLLING 1ST RATE PRAIRIE. GROWTH GRASS & WEEDS
- EAST ON RAND. BET 22 & 27
- 1650 LEFT PRAIRIE & ENTER TIMBER
- 2640 TEMPY 1/4 P
- 5247 INT. E BDY AT P. LAND 1ST 1/4 1ST RATE ROLLING PRAIRIE RUN OF ? ROLLING 2ND RATE WITH BURR RED HASH & W.O. ? HAZEL W.O BUSHES GRASS & WEEDS
- COR WEST
- 382.14 W.O. 24
- 2623.5 QUARTER SEC COR {BLK D 24 S84E 337.26 BLK D 16 S26W 275.22' BLK D 24 BLK D 16} MARKED
- 5247 SEC COR
- NORTH BET 21 & 22
- 1518 LEFT PRAIRIE & ENTER ? TIMBER
- 2640 QUARTER SEC COR. BURR O. 10 N87W 149.16' BURR O W.O} MARKED
- 2838 LEFT TIMBER & ENTER WET PRAIRIE
- 3630 LEFT WET PRAIRIE & ENTER ??
- 4382.4 BURR O 16
- 5280 COR TO SECS 15 16 21 22 {BURR O 24 S49W 48.18' BURR O 20 N47W 67.98' BURR O 18 N43E 99' BUR O 19 S34E 162.36' LAND & SAME A LAST MILE
- EAST ON RAND. SES 21 & 28
- 1056 BROOK 3.3' CRS N.E.
- 1386 THICKET
- 1782 LEFT THICKET & ENTER PRAIRIE
- 2640 TEMP 1/4 P
- 5267.46 INT. E BDY AT POST LAND HIGH ROLLING PRAIRIE 1ST RATE
- COR. WEST
- 2633.73 QUARTER SEC COR ON GROUND DESCENDING NE. SET POST & RAISED MOUND
- 5267.46 SEC COR
- 1844 TWP RD REC BK 1 PG 3 COMMENCING AT THE NE COR OF THE W 1/2 OF THE NW 1/4 OF SEC 26 T2N R11E IN SAID TOWN NEAR THE HOUSE OF WALTER INMAN AND RUNNING WEST ON THE LINE BETWEEN SECTIONS 23 & 26, 1325.28 TO THE COR SECTIONS 22,23,26, AND 27 WHITE OAK 36 INCHES BEARS N59W 64.03' N29E 1.00'; THENCE WEST ON LINE BETWEEN SECTIONS 22 AND 27, 5247' TO THE COR OF SECTION 21,22 AND 27 AND 28 SET POST IN MOUND WHERE OLD POST STOOD; THENCE WEST ON LAND BETWEEN SECTIONS 21 AND 28, 5267.46' TO COR OF SECTIONS 20,21 AND 28 AND 29, SET POST IN MOUND SIGHT OF OLD POST, THENCE WEST ON LINE BETWEEN 20 AND 29 UNTIL IT INTERSECTS THE BELOIT AND MADISON RD. SAID RD IS LAID OUT 66' WIDE OR 33' ON EACH SIDE OF THE LINE.
- 1847 TWP RD REC BK 1 PG 21 BEGINNING AT THE NW COR OF SEC 3 AND 4, 9 AND 10, 15 AND 16, 21 AND 22 TO THE SW COR OF SEC 22. SAID RD IS 66' IN WIDTH
- 1850 Mc VANE TWP RD REC BK 1 PG 28 BEGINNING AT THE NW COR OF THE EAST 1/2 OF THE SW 1/4 OF SEC 21-T2N R11E; THENCE RUNNING EAST ON THE QUARTER LINE OF SAID SECTION 2320'; THENCE N31E 3110' TO THE SE COR OF SEC; THENCE N37 1/2 828' TO THE NW COR OF THE SE 1/4 LINE OF SAID SEC 3960' TO THE NW COR OF THE NE 1/4 OF THE SW 1/4 OF SEC 14.

Donald Barnes

April 29, 2003

SHEET 1 OF 4 CORNER CODE R-13

PL587

SAID COURSE AND DISTANCES ARE THE CENTER OF THE ROAD.
VARIATION OF THE MAGNETIC NEEDLE 6 EAST.
1855 CHURCH VOL 1 PG 38 STONE 15" LONG 8" WIDE 4" THICK.
2725.8 TO N ¼ COR SEC 28 & 2655.18 TO E ¼ COR SEC 28
1868 LOCKE REMONUMENTATION NOTES PG 12 *SOUTH BETWEEN
SEG 27 AND 28 VAR 8*
2667.72 INTERSECTED ¼ LINE 20.46' EAST OF COR. FOUND
STONE SET BY CHURCH. (SEE COUNTY SURVEYORS
RECORD SEC 28) AT JUNCTION OF FENCES FROM
N.S AND E SEE PAGES 18 VAR CORRECTED 7-34.
*SET OFF 12.21' WEST AND CONTINUED
SOUTH FROM ¼ COR WITH VAR 7-25.*
5324.55 INTERSECTED SOUTH BOUNDARY 12.21' WEST OF
COR. FOUND B.TS IN SEC 27 AND 34 AND STUMP
OF BT IN 33 AND OLD STAKE BT IN 33 IS 89.1'
DIST. COR IN CENTER OF HIGHWAYS RUNNING E. S.
AND W. VAR CORRECTED
7-25
PG 20 EAST BETWEEN SECS 21 & 28 VAR 6-22
1082.4 CENTER OF SLUICE BRIDGE
1326.6 STONE SET BY CHURCH
2653.2 INTERSECTED ¼ LINE 17.16' NORTH OF COR AS SET
BY CHURCH (SEE PAGE 18 & ALSO CO. SURVEYORS
RECORD SEC 28) COR IN CENTER OF HIGHWAY &
NEARLY IN LINE WITH FENCE RUNNING SOUTH. VAR
CORRECTED 6
CONTINUED EAST FROM ¼ COR WITH VAR 5-50
4404.18 CENTER OF BRIDGE IN RAVINE
5308.38 INTERSECTED EAST BOUNDARY AT COR.
PG21 *NORTH BETWEEN SEC 21 & 22 VAR 8*
2662.44 INTERSECTED ¼ LINE 22.11' WEST OF COR. FOUND
STAKE AND WHERE BTS WERE DUG OUT COR IN
FENCE (N&S) VAR CORRECTED 7-31
*SET OFF 22.11' WEST AND CONTINUED NORTH
WITH VAR 7-35*
5309.7 INTERSECTED NORTH BOUNDARY 18.48' WEST OF
COR. FOUND BT IN SEC 21 AND STUMP OF BTS IN
15,16, & 22 AND OLD STAKE. VAR CORRECTED 7-40
AUG 22 1868
*PG 1 COMMENCED AT COR FOR SECS 21,22,27 & 28
FOUND COR AS SET BY CHURCH SEE COUNTY
SURVEYOR RECORD SEC 28 & UNDERNEATH
REMAINS OF STAKE. COR IN CENTER OF
HIGHWAY & IN LINE WITH FENCE RUNNING
SOUTH. EAST BETWEEN SECS 22 & 27 VAR 6-
15 EAST BETWEEN SECS 22 & 27 VAR 6-15*
2644.95 INTERSECTED ¼ LINE AT ¼ COR. FOUND WEST BT
AND STUMP OF EAST BT AND OLD STAKE. COR IN
CENTER OF HIGHWAY AND IN LINE WITH NORTH AND
SOUTH FENCES.
CONTINUED EAST FROM ¼ COR VAR 6
5279.01 INTERSECTED EAST BOUNDARY 9.9' NORTH OF COR
FOUND BTS IN SECS 23 & 27 & STUMPS OF BTS IN
22 & 26 DIST. TO BT IN 27 IS 163.35' DIST. TO
STUMP OF BT IN 26 IS 217.8' COR IN CENTER OF
HIGHWAY VAR CORRECTED 5-47 AUG 17, 1868
1876 RUGER VOL 2 PG 206 STONE MON. VAR 5-20 2640 TO N ¼
COR SEC 27 & 2661.12 TO W ¼ COR SEC 27
1966 BATTERMAN VOL 4 PG 261 DUG & FD NOTHING 7-29-74
CORNER RESET & REFERENCED BY H. COMBS.
1974 COMBS CSM VOL 4 PG 150 STATES NOTHING ABOUT MON.
2646.52 TO N ¼ COR SEC 27
1978 OFS CSM VOL 8 PG 189 STATES NOTHING ABOUT MON.
1978 BARNES VOL 5 PG 496 DUG & FD CUT STONE 36" DEEP.
SET ALUM. STONE IS 0.21' WEST & 0.07' NORTH OF FD PIPE.
COR @ CENTER PVMT & ON LINE N/S FENCE

SHEET 2 OF 4 CORNER CODE R-13

Donald Barnes

April 29, 2003

PL587

1995 LATHROP CSM VOL18 PG 456 ALUM. MON. 2655.10 TO
ALUM @ N ¼ COR SEC 28

FD ALUM. IN CENTER OF PVMT. & REFERENCE PIPES.

C) Was the corner restored through acceptance of (1) an obliterated evidence location, or, (2) a found perpetuated location?

ACCEPTED FD ALUM. MON. WHICH PERPETUATED THE CUT L.S.

D) Describe any material discrepancy between the location of the corner as restored or reestablished and the location of that corner as previously restored or reestablished by distance and direction. Show the discrepancy on the plan view drawing under (a), above. Show the distances between the corner as previously restored or reestablished and (1) the corner as restored or reestablished, and (2) to at least 4 of the witness monuments shown on the drawing in (a), above.

DISCREPANCY. NOTE IN VOL 5 PG 496. FD CUT STONE IS 36" DEEP.
ALUM. IS ON TOP OF STONE & IS 0.21' WEST & 0.7' NORTH OF FD
PIPE.

(E) Was the corner reestablished through lost corner proportionate methods? If so, show the method, including the directions and distances to other public land survey corners used as evidence or used for proportioning the corner location.


I, **Donald Barnes**, hereby certify that the corner location as identified by the corner code index was determined by me under my direction and control and that this U.S. Public Land Survey Monument Record is correct and complete to the best of my knowledge and belief.

Donald Barnes
Seal


APRIL 29, 2003
Emboss

SHEET 3 OF 4

CORNER CODE **R-13**
A-E 7.08 REQUIREMENT

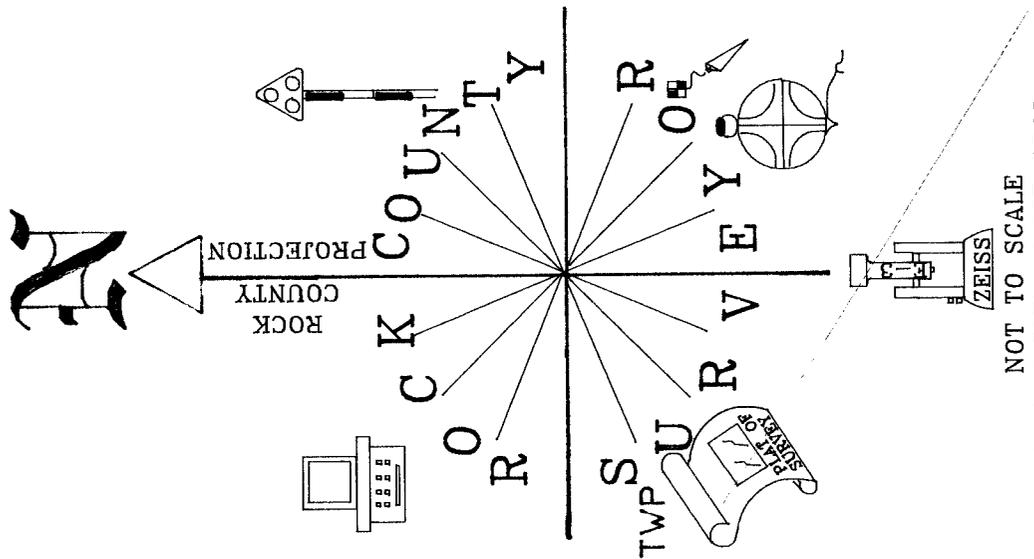

NOT TO SCALE
OBSERVATION SHEET #263

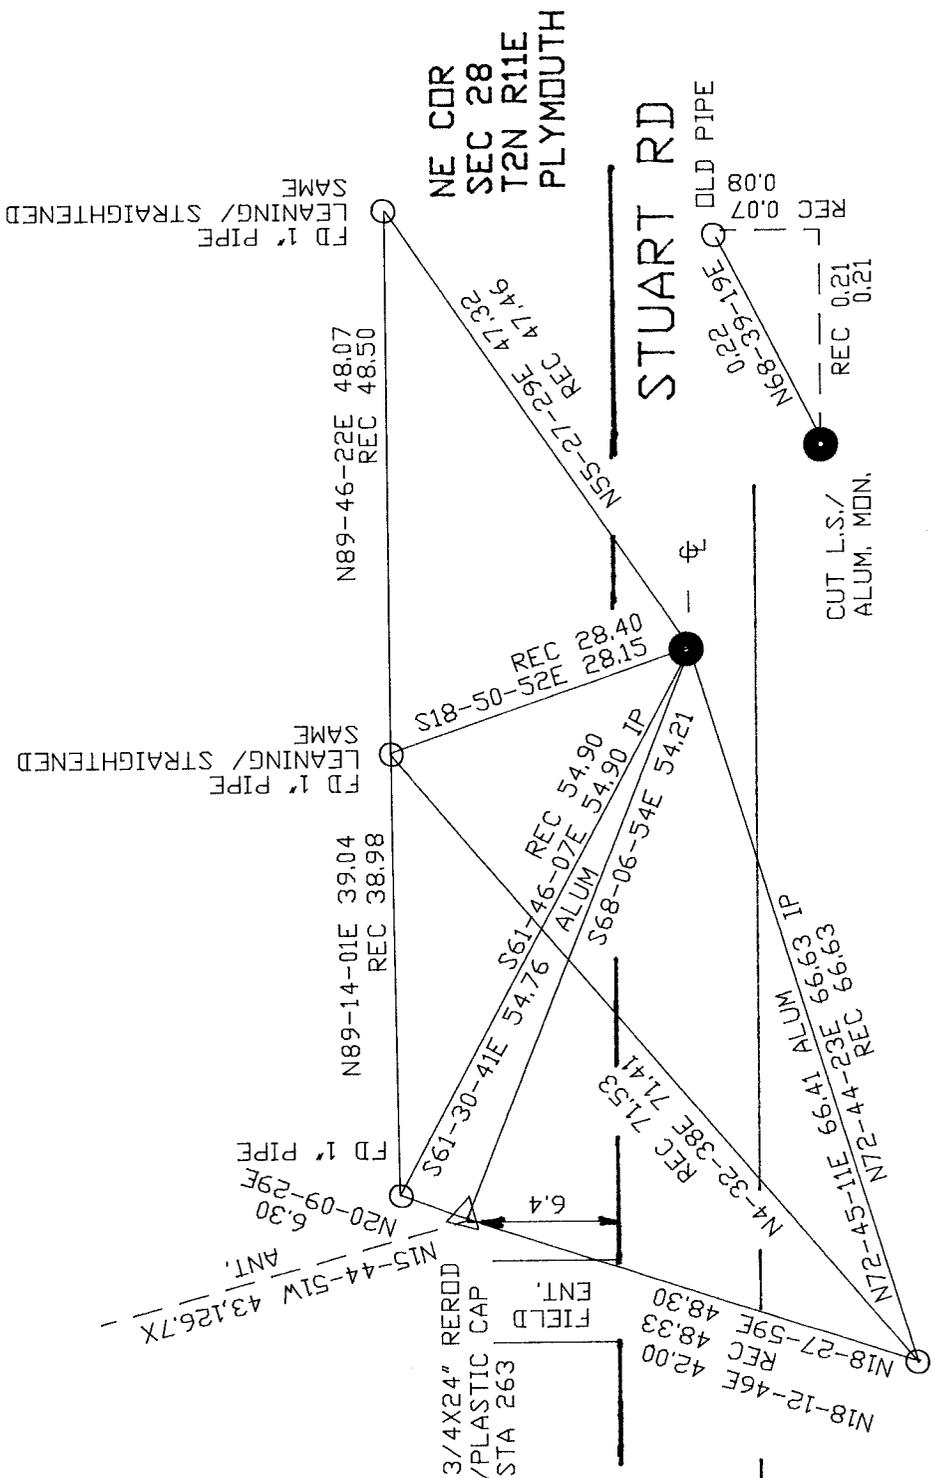

Donald Baines
EMBOSSSED SEAL

APR 29, 2003

SHEET 4 OF 4

R-13