

U.S. PUBLIC LAND SURVEY MONUMENT RECORD

For Public Land Survey Corners in:

WI ADMINISTRATIVE CODE A-E 7.08 REQUIREMENT

T. 2N., R. 11E

CORNER CODE INDEX

A	2	3	4	5	6	7	8	9	10	11	12	13	14	15	16	17	18	19	20	21	22	23	24	25
B	6																							
C																								
D																								
E																								
F	1																							
G																								
H																								
I																								
J																								
K																								
L	18																							
M		17																						
N			16																					
O				15																				
P					14																			
Q						13																		
R							12																	
S								11																
T									10															
U										9														
V											8													
W												7												
X													6											
Y														5										
Z															4									

PLYMOUTH TWP
ROCK COUNTY WI

IF AVAILABLE
ROCK COUNTY COORDINATES PREFERRED

North _____ Elev. _____

East _____

Hor. Datum _____ Vert. Datum _____

LATITUDE _____ ELLIPS. HT. _____

LONGITUDE _____

GPS (X) _____ TRAVERSE (X) _____


BASED ON THE FOLLOWING CONTROL:

PLACE MONUMENT SYMBOL \blacklozenge AT PROPER LOCATION ON ABOVE INDEX

\blacklozenge CORNER MONUMENT

\circ WITNESS MONUMENT

(a)

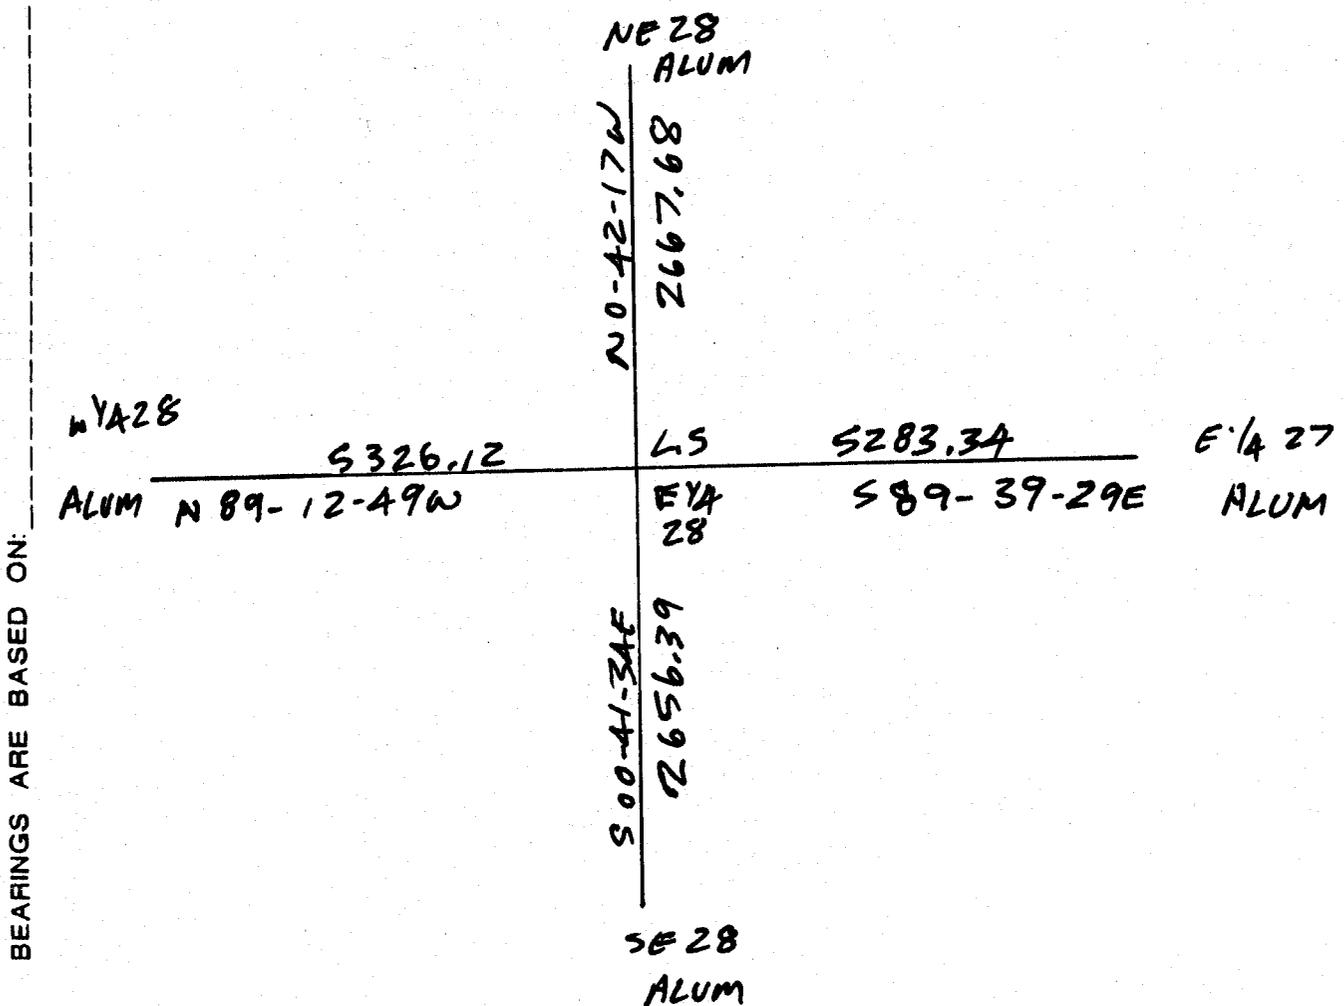

OBSERVATION SHEETS 179, 353, 414, 597

FIELD BOOK _____ PAGE # _____

SHEET 1 OF 1

SHOW A PLAN VIEW DRAWING DEPICTING THE CORNER MONUMENT AND SURROUNDING PHYSICAL FEATURES, INCLUDING THE EXCAVATION AREA AND DEPTH.

PLANNING & ZONING COMMITTEE ADOPTED THE ABOVE FORM ON 12/2/1982

CORNER CODE T-13

PL597

(B) Describe any record evidence, monument evidence, occupational evidence, testimonial evidence or any other material evidence you considered, and whether the monument was found or placed.

1833 HARRISON NORTH BETWEEN 27 & 28
858 LEFT TIMBER & ENTER PRAIRIE
2640 QUARTER SEC COR. POST & RAISED MOUND
5280 SET POST FOR COR TO SEC 21, 22, 27, 28 ON
GROUND DESCENDING N.W. SET POST & * RAISED A
MOUND. LAND MOSTLY HIGH ROLLING 1ST RATE
PRAIRIE. GROWTH GRASS & WEEDS
1855 CHURCH VOL 1 PG 38 STONE 18" LONG 8" WIDE 2655.18
TO NE COR SEC 28, 2646.27 TO SE COR SEC 28, 2654.85 TO
CENTER OF SEC 28, & 5315.31 TO W 1/4 COR SEC 28
1868 LOCKE REMONUMTATION NOTES PG 12 SOUTH BETWEEN SEC
27 AND 28 VAR B
2667.72 INTERSECTED 1/4 LINE 20.46' EAST OF COR.
FOUND STONE SET BY CHURCH. (SEE COUNTY
SURVEYORS RECORD SEC 28) AT JUNCTION OF
FENCES FROM N.S AND E SEE PAGES 18 VAR
CORRECTED 7-34.
SET OFF 12.21' WEST AND CONTINUED
SOUTH FROM 1/4 COR WITH VAR 7-25.
5324.55 INTERSECTED SOUTH BOUNDARY 12.21' WEST OF
COR. FOUND B.TS IN SEC 27 AND 34 AND STUMP
OF BT IN 33 AND OLD STAKE BT IN 33 IS 89.1'
DIST. COR IN CENTER OF HIGHWAYS RUNNING E.
S. AND W. VAR CORRECTED
7-25
1876 RUBER VOL 2 PG 206 STONE MON. 2661.12 TO NW COR
SEC 27, 2648.58 TO SW COR SEC 27, 2639.01 TO CENTER
SEC 27, & 5275.71 TO E 1/4 COR SEC 27
1984 COMBS MAP #13829 FD HARDHEAD STONE

FD CUT L.S. LEANING SOUTH. STRAIGHTENED L.S. & PLACED 2
MAGNETS 18" DEEP ON NORTH & SOUTH. PLACED CARBONITE ON
SOUTH SIDE.

C) Was the corner restored through acceptance of (1) an obliterated evidence location, or, (2) a found
perpetuated location?

ACCEPTED FD CUT L.S.

D) Describe any material discrepancy between the location of the corner as restored or reestablished
and the location of that corner as previously restored or reestablished by distance and direction. Show
the discrepancy on the plan view drawing under (a), above. Show the distances between the corner as
previously restored or reestablished and (1) the corner as restored or reestablished, and (2) to at least
4 of the witness monuments shown on the drawing in (a), above.

(E) Was the corner reestablished through lost corner proportionate methods? If so, show the method,
including the directions and distances to other public land survey corners used as evidence or used for
proportioning the corner location.

I, Donald Barnes, hereby certify that the corner location as identified by the corner code index
was determined by me under my direction and control and that this U.S. Public Land Survey
Monument Record is correct and complete to the best of my knowledge and belief.

Seal

Donald Barnes

Emboss

6-10-03

SHEET 1 OF 1

CORNER CODE

T-13

A-E 7.08 REQUIREMENT