
U.S.

LAND **PUBLIC** SURVEY MONUMENT RECORD

For	Public La	and Survey	Corners	in:	WI	ADMINISTRATIVE	CODE	A-E 7.08	REQUIREMENT
		2 1 1							

· T.∠N., R. ∠∠_E

CORNER CODE INDEX

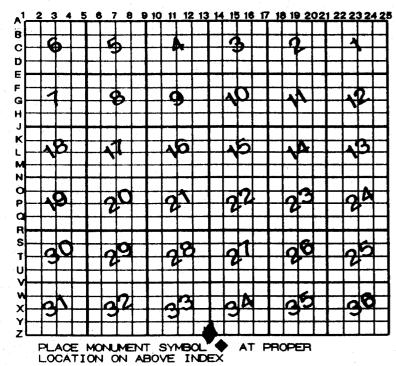

PLYMOUTY

ROCK COUNTY WI

IF AVAILABLE ROCK COUNTY COORDINATES PERFERRED

North	Elev					
East						
Hor. Datum	Vert. Datum					
LATITUDE _	ELLIPS. HT					
LONGITUTE _						
GPS (X)	TRAVERSE (X)					
BASED ON THE	FOLLOWING CONTROL:					

♦CORNER MONUMENT

O WITNESS MONUMENT

BEARINGS ARE BASED ON:

(a)

								2_
FIELD	воок	PAGE #			SHEET		OF	
		DRAWING DEPICTING TH			SURRO	UNDING		
PHYSIC	AL FEATURES,	INCLUDING THE EXCAVA	ATION AREA AND DEPT	H.				
PLANNIN	G & ZONING COM	MITTEE ADOPTED THE ABOV	E FORM ON 12/2/1982					

PL627

(B)Describe any record evidence, monument evidence, occupational evidence, testimonial evidence or any other material evidence you considered, and whether the monument was found or placed.

1833 MULLETT

WEST ON SOUTH SIDE SECTION 33

- 2640 SET QUARTER SECTION POST IN PRAIRIE AND MOUND OF EARTH AND SODS
- 3102 INDIAN PATH CS S.E.
- 5280 SET POST CORNER SECTIONS 32 & 33 MADE A MOUND OF EARTH AND SODS LAND ROLLING SECOND RATE DRY PRAIRIE

WEST ON SOUTH SIDE SECTION 34

- 2640 SET QUARTER SECTION POST WHITE OAK 16 N29E 155.76' BUR OAK ; BUR OAK 12 N60 1/2W 167.64';
- 3960 ENTER PRAIRIE
- 5280 SET POST CORNER SECTIONS 33 & 34 MADE A MOUND OF STONES 3 FEET IN DIAMETER AT BASE & 3 FEET HIGH FIRST 3/4 THINLY TIMBERED WITH BLACK WHITE AND BUR OAK THICK UNDERGROWTH HAZEL BRIERS GRAPE VINES & LAST 1/4 RICH DRY PRAIRIE.

1833 HARRISON

NORTH BETWEEN SECS 33 & 34 T2N R11E

1188 LEFT PRAIRIE & ENTER TIMBER

1683 WHITE OAK 26

2268.42 WHITE OAK 18

2640 QUARTER SEC COR. BLK O 24 N35E 48.18'; WHITE OAK 16 S21E 31.02

4066.26 BLK O 36

5181.66 BLK O 28

5280 COR TO SEC 27,28,33,34 WHITE OAK 24 S35E 114.18'; LYM? 24
N78E 86.46'; RED O 30 N46W 45.54'; W.O. 34 S31W 75.9'; LAND ? 1ST RATE
TIMB. BLK & W.O. ASPIN HICKORY. ? & LITTLE OR NO
UNDERGROWTH

1834 MILLER MARCH 10

NORTH BETWEEN SECS 3 & 4

2319.9 TRAIL CRS N.W.

2640 SET 1/4 SECS POST IN MOUND OF EARTH AND SOD

5283.3 INTERSECT N. BOUNDARY. 33.66' EAST OF POST. SET POST IN MOUND OF STONE. COR OF SEC 3 & 4. LAND ROLLING 2ND RATE.

1868 LOCKE PLYMOUTH REMONUMENTATION AUG 21 1868

PG 16 WEST ON SOUTH LINE SEC 34 VAR 6

- 264 SET OFF 3.3' SOUTH
- 528 SET OFF 6.6' SOUTH
- 1122 SET OFF 1.32' SOUTH
- 1518 SET OFF 1.65' SOUTH
- 2673 INTERSECTED 1/4 LINE 14.52' SOUTH OF COR. FOUND BTS AND OLD STAKE. VAR CORRECTED 5-58

CONTINUED WEST FROM 1/4 COR WITH VAR 6-22

- 3762 ENTER PRAIRIE
- 5339.4 INTERSECTED WEST BOUNDARY 30.36' SOUTH OF COR. FOUND LARGE LIMESTONE SET FOR CORNER. COR IN CENTER HIGHWAYS RUNNING N.E.&W SET MONUMENT IN MOUND OF STONES COVERED WITH EARTH. VAR CORRECTED 5-43 1/4 MONUMENT MARKED 34 ON NORTH FACE.

PG 17 NORTH BETWEEN SEC 33 & 34 VAR 7 AUG 21 1868

- 2655.18 INTERSECTED 1/4 LINE .66' EAST OF COR. FOUND STUMPS OF BTS AND STAKE UNDER STONE ON CORNER. THE DISTANCE & COURSE OF EACH BT GIVEN FOR THE OTHER RIGHT WHEN EXCHANGED. COR IN CENTER OF HIGHWAY & IN LINE OF E & W FENCE. VAR CORRECTED 7-01. CONTINUED NORTH FROM 1/4 COR WITH VAR 7
- 3118.5 BROOK 3.96' WIDE COURSE SW
- 5318.28 INTERSECTED NORTH BOUNDARY 3.3' E OF COR.

VAR CORRECTED 7-04.

SHEET 1 OF 2

6-29-01

U.S.

PUBLIC LAND SURVEY MONUMENT RECORD

For Public Land Survey Corners in: T. N., R. E	WI ADMINISTRATIVE CODE A-E 7.08 REQUIREMENT
CORNER CODE INDEX A1 2 3 4 5 6 7 8 9 10 11 12 13 14 15 16 17 18 19 2021 22 23 B C	PLYMOUTH TWP ROCK COUNTY WI
	IF AVAILABLE ROCK COUNTY COORDINATES PERFERRED
	North Elev East Vert. Datum
9 20 21 22 23 2	
S 30 29 28 21 26 2	LONGITUTE GPS (X) TRAVERSE (X)
× 3 3 3 3 3 3 3 3 3 3 3 3 3 3 3 3 3 3 3	
PLACE MONUMENT SYMBOL AT PROPER LOCATION ON ABOVE INDEX CORNER MONUMENT	○ WITNESS MONUMENT

Fd MES IN VOL5
P6 203

BEARINGS ARE BASED ON:

				•		-	
FIELD	ВООК	PAGE #			SHEET _	\geq of	
		DRAWING DEPICTIN		MONUMENT AND	SURROU	NDING	
PHYSIC	AL FEATURES,	INCLUDING THE EX	CAVATION AREA	A AND DEPTH.			
PLANNIN	G & ZONING COM	MITTEE ADOPTED THE	ABOVE FORM ON	12/2/1982			

- 1712.04 CENTER SLUICE BRIDGE 3.96'
- 2648.91 INTERSECTED 1/4 LINE AT COR. FOUND OLD STAKE IN CENTER OF HIGHWAY AND IN LINE WITH FENCE RUNNING NORTH. SURROUNDED MONUMENT BY HEAP OF LIMESTONES. CONTINUED WEST WITH VAR 6-20
- 2705.34 CENTER OF SOUTH END OF BRIDGE
- 5340.39 INTERSECTED WEST BOUNDARY 12.87' SOUTH OF OCR. VAR. CORRECTED 6-04' 1/4 MONUMENT MARKED 33 ON ITS NORTH FACE.
- **COLLINS REMONUMENTATION**

PG 172 NORTH BETWEEN 3 & 4 VARIATION 6-30

- 2682.9 SET 1/4 STONE IN LINE WITH FENCES EAST & WEST. **CONTINUED NORTH VARIATION 6-25**
- SET STONE FOR CORNER OF 3 & 4 33.66' EAST OF PLYMOUTH CORNER. 5134.8 **PG 173** EAST ON NORTH LINE OF SEC 3. VARIATION 5-50
- 5280 SECTION CORNER

BACK TO

SET 1/4 STONE 1.98' EAST OF PLYMOUTH CORNER. OCT 26, 1871 2640 EAST ON NORTH LINE OF 4 VARIATION 5-40

SECTION CORNER 5334.12

BACK TO

2667.06 SET 1/4 STONE 31.02' EAST OF PLYMOUTH 1/4 CORNER. NOV 6TH 1871

- 1871 RUGER VOL 2 PG 75 FD STONE MON. SE COR SEC 33 TO E 1/4 COR SEC 33 2650.06' VAR 6-15 & 2667.88 VAR 5-25 SE COR SEC 33 TO S 1/4 COR SEC 33.
- 1873 RUGER VOL 2 PG 117 STONE MON. AT NW COR SEC 3 & SE COR SEC 33.66' EAST OF PLYMOUTH COR.
- RUGER VOL 2 PG 403 2632.74 TO N 1/4 COR SEC 3, 2488.86 TO W 1/4 COR SEC 3. 1882
- 1882 HOLMES VOL 2 PG 349 CALLS FOR MON. 2487.21 TO W 1/4 COR SEC 3
- .1957 BATTERMAN VOL 3 PG 520 33.66 BETWEEN CORNERS. NEWARK IS EAST OF PLYMOUTH. 2640.72 TO THE WEST & 2637.63 TO THE EAST.
- BATTERMAN VOL 4 PG 317 FD CUT L.S. AT SE COR SEC 33 & NE COR SEC 4. 1967 33.45 BETWEEN CORNERS. REFERENCED SAME
- BARNES VOL 5 PG 203 33.46 BETWEEN CORNERS. REFERENCED SAME. 1976
- BARNES VOL 5 PG 473 33.45 BETWEEN CORNERS. FROM SE COR SEC 33 N89-02-1978 54W 2640.64 TO N 1/4 COR SEC 4, N0-00-02W 2655.96 TO E 1/4 COR SEC 33, & 2670.88 TO S 1/4 COR SEC 33.
- BARNES VOL 5 PG 481 SE COR SEC 33 FD PK & 6" DEEP FOUND CUT L.S. SET 6" ALUM. MON. AT NE COR SEC 4 FD PK & 18" DEEP FD CUT L.S. SET 18" ALUM. MON.

FD ALUM. MON @ CENTER OF E/W PAVEMENT CENTER LINE.

C) Was the corner restored through acceptance of (1) an obliterated evidence location, or, (2) a found perpetuated location?

ACCEPTED FOUND CORNER AS PERPETUATED.

I, Donald Barnes, hereby certify that the corner location as identified by the corner code index was determined by me under my direction and control and that this U.S. Public Land Survey Monument Record is correct and complete to the best of my knowledge and belief.

SHEET 2 OF 3

emboss (0-7-9-01

CORNER CODE Z-13

A-E 7.08 REQUIREMENT