

e.)

U.S. PUBLIC LAND SURVEY MONUMENT RECORD

For Public Land Survey Corners in the T. 2N., R. // E.

CORNER CODE INDEX

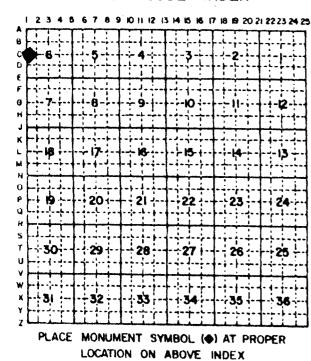

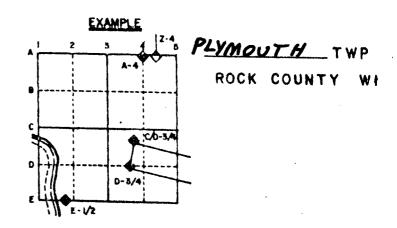

IF AVAILABLE STATE PLANE COORDINATES


North (Y) 243, 142,83 Eleve. (2)


East (X) 2, 202,094,68 Zone

Vert. Datum

CORNER MONUMENT

O WITNESS MONUMENT

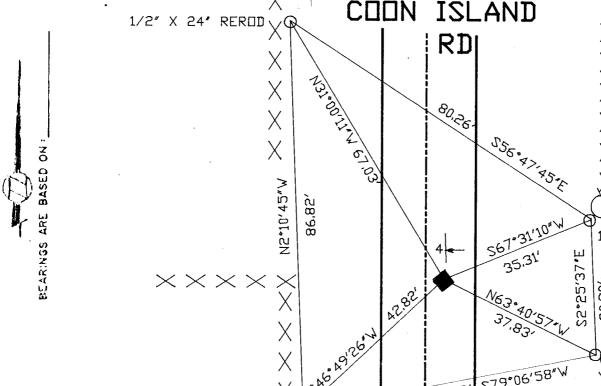

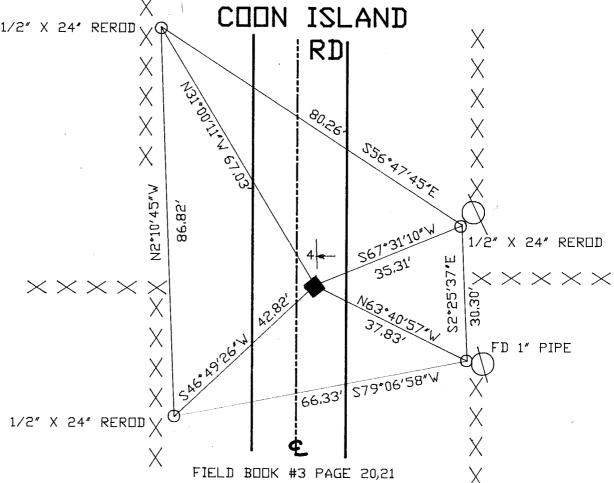

SHEET___ OF___

CORNER CODE: C1

- (B) Describe any record evidence, monument evidence, occupational evidence, testimonial evidence or any other material evidence you considered, and whether the monument was found or placed.
- 1867 FOUND STUMP'S OF B.T.S AND STAKE. PLACED STAKE SURROUNDED BY 3 LIMESTONES IN MOUND. SHOWS A DISTANCE OF 2615.25 TO CENTER OF SECTION 6.
- 1868 LOCKE REMONUMENTATION FIELD NOTES. INTERSECTED 1/4 LINE 38 1/2 LINES WEST OF CORNER FOUND CORNER AS SET BY SELF. CORNER IN LINE OF RAIL FENCE RUNNING E&W. PLACED CUT LINESTONE. SHOWS A DISTANCE OF 2649.57' TO NW CORNER AND 2590.50 TO SW CORNER OF SECTION 6.
- 1870 RUGER VOL 2 PG 16 FOUND STONE CORNER POST SET BY LOCKE. SHOWS A DISTANCE OF 2586.54' TO SW CORNER AND 2603.92 TO CENTER OF SECTION 6. THIS IS DIFFERENT THAN THAT SHOWN IN VOL 6 PG 405.
- 1870 RUGER VOL 6 PG 405. SAME AS VOL 2 PG 16 EXCEPT THE DISTANCE TO THE SOUTH WEST IS 2583.57 AND THE DISTANCE TO THE CENTER IS 2622.02'.

DUG AND FOUND CUT LIMESTONE 2.3 DEEP. STONE IS 4.5' EAST OF CENTER OF THE PAVEMENT. PLACED 2 MAGNETS ON TOP OF STONE.

- C) Was the corner restored through acceptance of (1) an obliterated evidence location, or, (2) a found perpetuated location?
- D) Describe any material discrepancy between the location of the corner as restored or reestablished and the location of that corner as previously restored or reestablished by distance and direction. Show the discrepancy on the plan view drawing under (a), above. Show the distances between the corner as previously restored or reestablished and (1) the corner as restored or reestablished, and (2) to at least 4 of the witness monuments shown on the drawing in (a), above.
- (E) Was the corner reestablished through lost corner proportionate methods? If so, show the method, including the directions and distances to other public land survey corners used as evidence or used for proportioning the corner location.
- I, Donald Barnes, hereby certify that the corner points as identified by the corner code index were, in a field survey on. October 17,1989, established, re-established, monumented, remonumented, recovered or restored as expressed below and in conformance with the regulations and rules as required in the current manual of survey instructions of the United States Department of Interior, Bureau of Land Management.

Date of computer entry

Date microfilmed

Number of included sheets

CORNER CODE

MAFFIX YOUR LAND SURVEYOR SEAL