

U.S. PUBLIC LAND SURVEY MONUMENT RECORD


For Public Land Survey Corners in the
T. 2 N., R. 11 E.

CORNER CODE INDEX

| | | | | | | | | | | | | | | | | | | | | | | | | | |
|---|---|---|---|----|----|----|----|----|----|----|----|----|----|----|----|----|----|----|----|----|----|----|----|----|----|
| | 1 | 2 | 3 | 4 | 5 | 6 | 7 | 8 | 9 | 10 | 11 | 12 | 13 | 14 | 15 | 16 | 17 | 18 | 19 | 20 | 21 | 22 | 23 | 24 | 25 |
| A | | | | | | | | | | | | | | | | | | | | | | | | | |
| B | | | | | | | | | | | | | | | | | | | | | | | | | |
| C | 6 | | | | | | | | | | | | | | | | | | | | | | | | |
| D | | 5 | | | | | | | | | | | | | | | | | | | | | | | |
| E | | | 4 | | | | | | | | | | | | | | | | | | | | | | |
| F | | | | 3 | | | | | | | | | | | | | | | | | | | | | |
| G | | | | | 2 | | | | | | | | | | | | | | | | | | | | |
| H | | | | | | | | | | | | | | | | | | | | | | | | | |
| I | | | | | | | | | | | | | | | | | | | | | | | | | |
| J | 7 | | | | | | | | | | | | | | | | | | | | | | | | |
| K | | 8 | | | | | | | | | | | | | | | | | | | | | | | |
| L | | | 9 | | | | | | | | | | | | | | | | | | | | | | |
| M | | | | 10 | | | | | | | | | | | | | | | | | | | | | |
| N | | | | | 11 | | | | | | | | | | | | | | | | | | | | |
| O | | | | | | 12 | | | | | | | | | | | | | | | | | | | |
| P | | | | | | | 13 | | | | | | | | | | | | | | | | | | |
| Q | | | | | | | | 14 | | | | | | | | | | | | | | | | | |
| R | | | | | | | | | 15 | | | | | | | | | | | | | | | | |
| S | | | | | | | | | | 16 | | | | | | | | | | | | | | | |
| T | | | | | | | | | | | 17 | | | | | | | | | | | | | | |
| U | | | | | | | | | | | | 18 | | | | | | | | | | | | | |
| V | | | | | | | | | | | | | 19 | | | | | | | | | | | | |
| W | | | | | | | | | | | | | | 20 | | | | | | | | | | | |
| X | | | | | | | | | | | | | | | 21 | | | | | | | | | | |
| Y | | | | | | | | | | | | | | | | 22 | | | | | | | | | |
| Z | | | | | | | | | | | | | | | | | 23 | | | | | | | | |
| | | | | | | | | | | | | | | | | | | 24 | | | | | | | |
| | | | | | | | | | | | | | | | | | | | 25 | | | | | | |
| | | | | | | | | | | | | | | | | | | | | 26 | | | | | |
| | | | | | | | | | | | | | | | | | | | | | 27 | | | | |
| | | | | | | | | | | | | | | | | | | | | | | 28 | | | |
| | | | | | | | | | | | | | | | | | | | | | | | 29 | | |
| | | | | | | | | | | | | | | | | | | | | | | | | 30 | |
| | | | | | | | | | | | | | | | | | | | | | | | | | 31 |
| | | | | | | | | | | | | | | | | | | | | | | | | | 32 |
| | | | | | | | | | | | | | | | | | | | | | | | | | 33 |
| | | | | | | | | | | | | | | | | | | | | | | | | | 34 |
| | | | | | | | | | | | | | | | | | | | | | | | | | 35 |
| | | | | | | | | | | | | | | | | | | | | | | | | | 36 |

PLACE MONUMENT SYMBOL (◊) AT PROPER LOCATION ON ABOVE INDEX

EXAMPLE

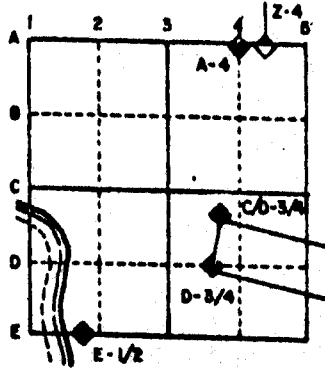

PLYMOUTH TWP
ROCK COUNTY WI


IF AVAILABLE
STATE PLANE COORDINATES

North (Y) 240,552.10 Elev. (Z) _____
 East (X) 2,202,103.44 zone _____
 Hor. Datum _____ Vert. Datum _____

e.) CORNER MONUMENT WITNESS MONUMENT

ALUM MON
 1/2" X 24" REBAR

BEARINGS ARE BASED ON STATE PLANE

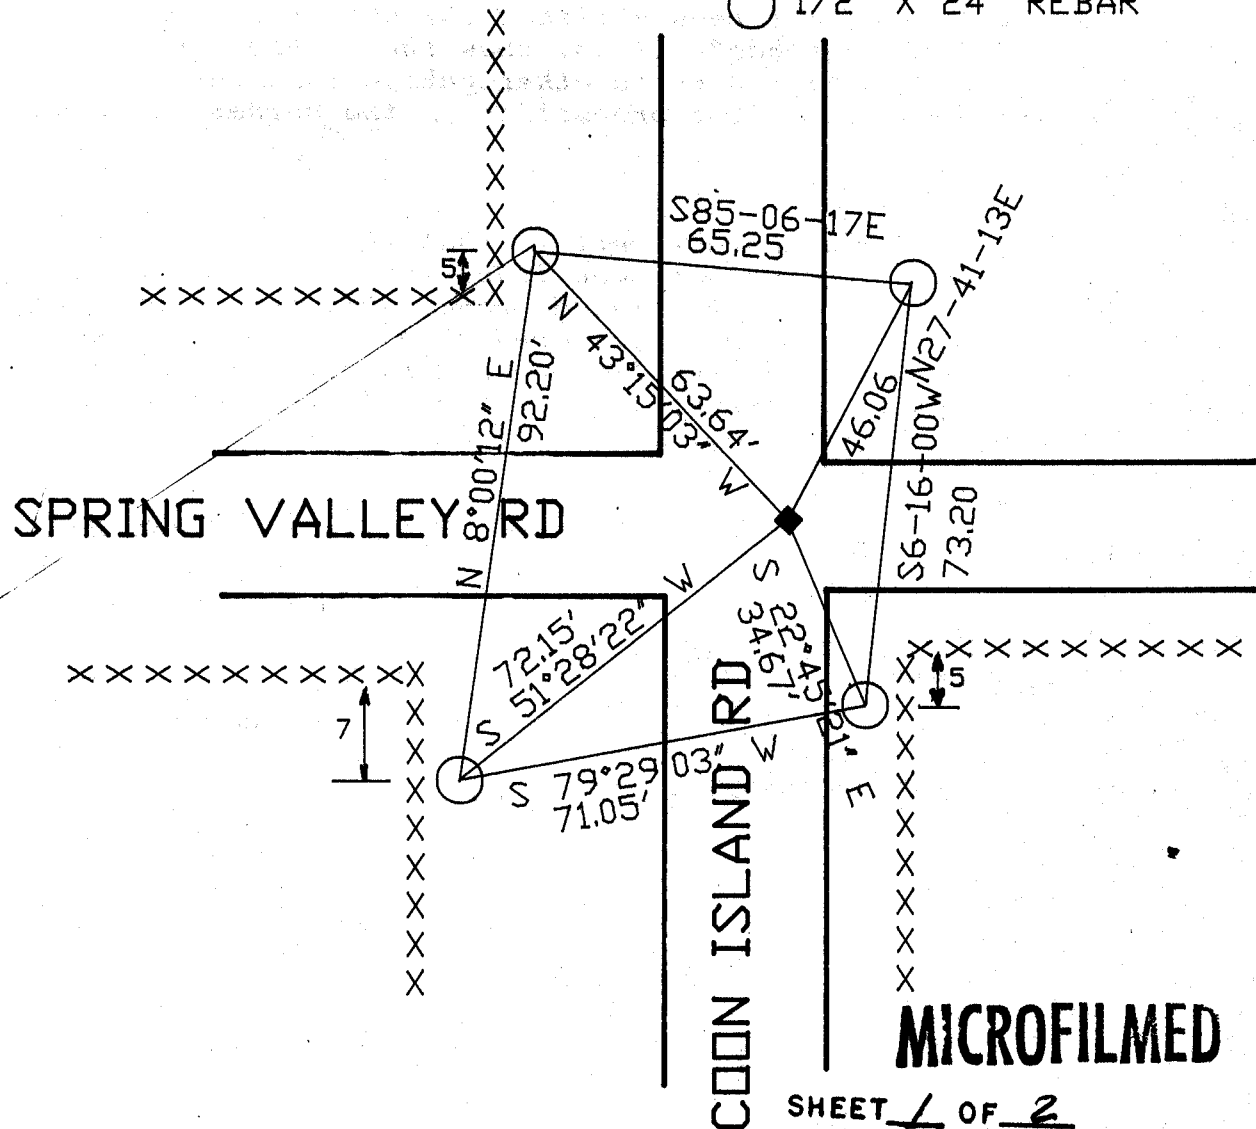

MICROFILMED

SHEET 1 OF 2

CORNER CODE: E1

FIELD BOOK 3
PG. 18, 22

(B) Describe any record evidence, monument evidence, occupational evidence, testimonial evidence or any other material evidence you considered, and whether the monument was found or placed.

1867 LOCKE VOL 1 PG 285 FOUND POST IN MOUND.

1868 LOCKE REMONUMENTATION FIELD NOTES. FOUND STAKE IN MOUND 43 LKS N OF AND IN LINE OF FENCE ON EAST SIDE OF HIGHWAY. PLACED CUT LIMESTONE.

1870 RUGER VOL 2 PG 16 FOUND STONE PLACED BY LOCKE.

1870 RUGER VOL 2 PG 17 FOUND STONE PLACED BY LOCKE.

1979 BARNES VOL 6 PG 7 DUG 5' DEEP AND FOUND NOTHING.

DUG ANOTHER HOLE THAT IS EAST OF PREVIOUS ONE. AREA INDICATES THERE WAS A ROAD CUT. I PROPRATED WITH LOCKE'S 1868 REMONUMENTATION DISTANCES FROM THE WEST QUARTER CORNER OF SECTION 7 TO THE WEST QUARTER CORNER OF SECTION 6 FOR THE NORTH/SOUTH POSITION. I USED LOCKE'S DISTANCES FROM THE NORTHWEST CORNER OF SECTION 6 TO THE WEST QUARTER CORNER OF SECTION 7 AND THE NORTH LINE OF THE NORTHEAST QUARTER OF SECTION 7 FOR THE PRORATION OF THE EAST/WEST DISTANCE. THIS IS ALSO IN HARMONY WITH THE NORTH LINE OF SECTION 12 OF SPRING VALLEY.

C) Was the corner restored through acceptance of (1) an obliterated evidence location, or, (2) a found perpetuated location?

ACCEPTED OBLITERATED EVIDENCE LOCATION.

D) Describe any material discrepancy between the location of the corner as restored or reestablished and the location of that corner as previously restored or reestablished by distance and direction. Show the discrepancy on the plan view drawing under (a), above. Show the distances between the corner as previously restored or reestablished and (1) the corner as restored or reestablished, and (2) to at least 4 of the witness monuments shown on the drawing in (a), above.

(E) Was the corner reestablished through lost corner proportionate methods? If so, show the method, including the directions and distances to other public land survey corners used as evidence or used for proportioning the corner location.

I, Donald Barnes, hereby certify that the corner points as identified by the corner code index were, in a field survey on, November 19, 1989, established, re-established, monumented, re-monumented, recovered or restored as expressed below and in conformance with the regulations and rules as required in the current manual of survey instructions of the United States Department of Interior, Bureau of Land Management.


COUNTY SURVEYOR FILING DATA

Date of computer entry _____

Date microfilmed _____

Number of included sheets 6
CORNER CODE

AFFIX YOUR LAND SURVEYOR SEAL

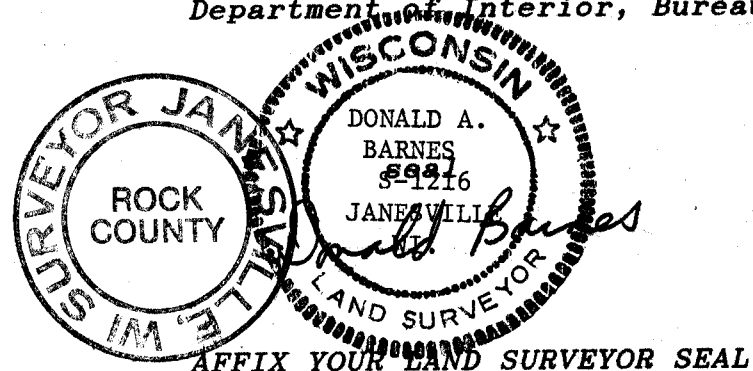

U.S. PUBLIC LAND SURVEY MONUMENT RECORD


For Public Land Survey Corners in the
T. 2 N., R. 11 E.

CORNER CODE INDEX

| | | | | | | | | | | | | | | | | | | | | | | | | | |
|---|---|----|---|----|---|----|---|----|---|----|----|----|----|----|----|----|----|----|----|----|----|----|----|----|----|
| | 1 | 2 | 3 | 4 | 5 | 6 | 7 | 8 | 9 | 10 | 11 | 12 | 13 | 14 | 15 | 16 | 17 | 18 | 19 | 20 | 21 | 22 | 23 | 24 | 25 |
| A | | | | | | | | | | | | | | | | | | | | | | | | | |
| B | | | | | | | | | | | | | | | | | | | | | | | | | |
| C | | 6 | | 5 | | 4 | | 3 | | 2 | | | | | | | | | | | | | | | |
| D | | | | | | | | | | | | | | | | | | | | | | | | | |
| E | | | | | | | | | | | | | | | | | | | | | | | | | |
| F | | | | | | | | | | | | | | | | | | | | | | | | | |
| G | | 7 | | 8 | | 9 | | 10 | | 11 | | | | | | | | | | | | | | | |
| H | | | | | | | | | | | | | | | | | | | | | | | | | |
| I | | | | | | | | | | | | | | | | | | | | | | | | | |
| J | | | | | | | | | | | | | | | | | | | | | | | | | |
| K | | | | | | | | | | | | | | | | | | | | | | | | | |
| L | | 16 | | 17 | | 18 | | 19 | | 20 | | | | | | | | | | | | | | | |
| M | | | | | | | | | | | | | | | | | | | | | | | | | |
| N | | | | | | | | | | | | | | | | | | | | | | | | | |
| O | | | | | | | | | | | | | | | | | | | | | | | | | |
| P | | 19 | | 20 | | 21 | | 22 | | 23 | | | | | | | | | | | | | | | |
| Q | | | | | | | | | | | | | | | | | | | | | | | | | |
| R | | | | | | | | | | | | | | | | | | | | | | | | | |
| S | | | | | | | | | | | | | | | | | | | | | | | | | |
| T | | 30 | | 29 | | 28 | | 27 | | 26 | | | | | | | | | | | | | | | |
| U | | | | | | | | | | | | | | | | | | | | | | | | | |
| V | | | | | | | | | | | | | | | | | | | | | | | | | |
| W | | | | | | | | | | | | | | | | | | | | | | | | | |
| X | | 31 | | 32 | | 33 | | 34 | | 35 | | | | | | | | | | | | | | | |
| Y | | | | | | | | | | | | | | | | | | | | | | | | | |
| Z | | | | | | | | | | | | | | | | | | | | | | | | | |

PLACE MONUMENT SYMBOL (◆) AT PROPER LOCATION ON ABOVE INDEX

EXAMPLE

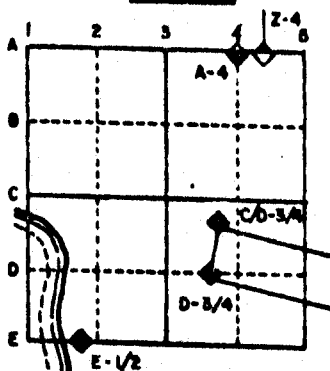

PLYMOUTH TWP
ROCK COUNTY WI


IF AVAILABLE
STATE PLANE COORDINATES

North (Y) 240,554.10 Elev. (Z) _____
 East (X) 2,202,103.74 Zone _____
 Hor. Datum _____ Vert. Datum _____

e.)

◆ CORNER MONUMENT

○ WITNESS MONUMENT

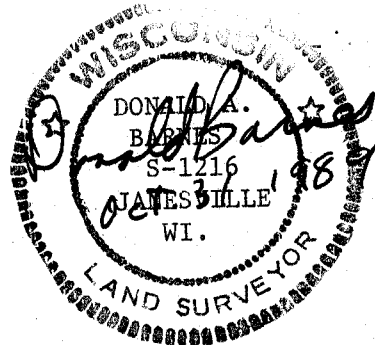


BEARINGS ARE BASED ON:

SPRING VALLEY RD

SMALL HOLE DUG 4' DEEP TO BED ROCK & FOUND NOTHING

FIELD BOOK #3
PAGE 18,22,23

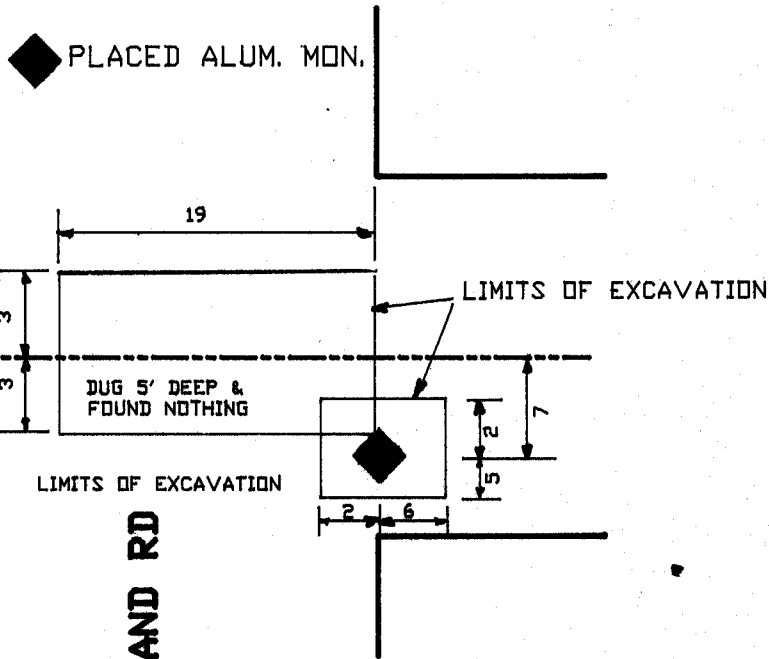

COON ISLAND RD

MICROFILMED

SHEET 2 OF 2

CORNER CODE: E1