

(b.) Describe any record evidence, monument evidence, occupational evidence, testimonial evidence or any other material evidence you considered, and whether the monument was found or placed.

1867 LOCKE VOL 1 PG 304 FOUND E.B.T. & SET STAKE WITH HH ON E&W AND 2 LIMESTONES ON N & 2 ON S.

1873 LEE VOL 2 PG 96 FOUND STAKE SET BY LOCKE & NE B.T.

1882 RUGER VOL 2 PG 410 USED CORNER BUT STATED NOTHING ABOUT CORNER

1937 SUNNY VOL 3 PG 354 COVERED WITH CONCRETE ROAD OVER MARSH. DID NOT DIG FOR IT

1982 BARNES VOL 6 PG 268 DUG & FOUND 1 1/2' DEEP 2 HH ON E&W AND 2 LIMESTONES ON N & S. DID NOT FIND THE WOOD STAKE NOR WOOD FIBERS.

FOUND PK 10.00 TO THE WEST AND SOUTH. PLACED POLY MONUMENT


(c.) Was the corner restored through acceptance of (1) an obliterated evidence location, or, (2) a found perpetuated location?

ACCEPTED FOUND PERPETUATED LOCATION



(d.) Describe any material discrepancy between the location of the corner as restored or reestablished and the location of that corner as previously restored or reestablished by distance and direction. Show the discrepancy on the plan view drawing under (a), above. Show the distances between the corner as previously restored or reestablished and (1) the corner as restored or reestablished, and (2) to at least 4 of the witness monuments shown on the drawing in (a), above.

(e.) Was the corner reestablished through lost corner proportionate methods? If so, show the method, including the directions and distances to other public land survey corners used as evidence or used for proportioning in determining the corner location.

NO

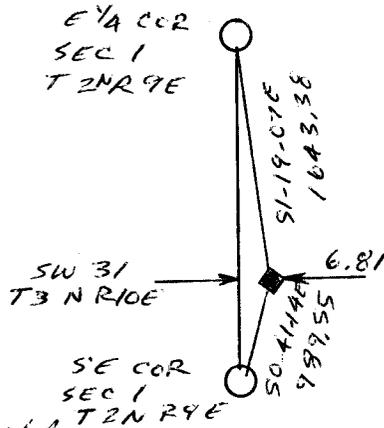

I, Donald Barnes, hereby certify that the corner points as identified by the corner code index were, in a field survey on July 1 1987, established, re-established, monumented, re-monumented, recovered or restored as expressed below and in conformance with the regulations and rules as required in the current manual of survey instructions of the United States Department of Interior, Bureau of Land Management.

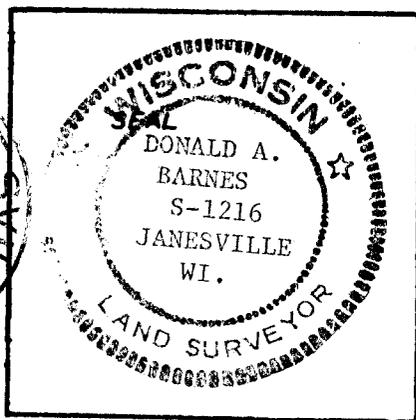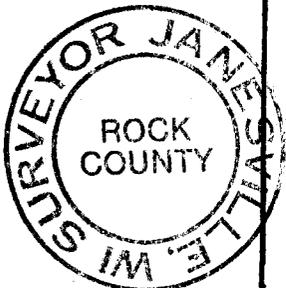

COUNTY SURVEYOR FILING DATA

Date of Computer Entry _____

Date Received _____

Date Microfilmed _____

Treasurer's Receipt No. _____

Number of Included Sheets _____

AFFIX YOUR LAND SURVEYOR SEAL. CORNER CODE 21