
U.S.

## PUBLIC LAND SURVEY MONUMENT RECORD

For	Public	Land	Survey	Corners	in:	WI	<b>ADMINISTRATIVE</b>	CODE	A-E	7.08	REQUIREMENT
		,									

. T. \_/N., R. \_//\_E

CORNER CODE INDEX

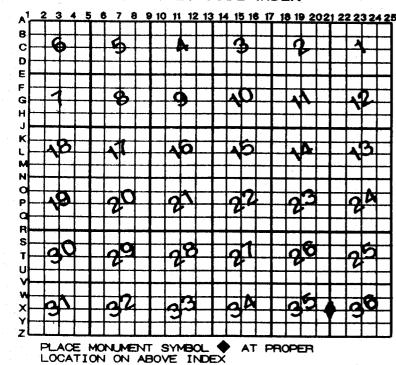

## NEWARK TWP

IF AVAILABLE
ROCK COUNTY COORDINATES PERFERRED

North	Elev
East	· · · · · · · · · · · · · · · · · · ·
Hor. Datum	Vert. Datum
LATITUDE	ELLIPS HT
LONGITUTE	
GPS (X)	TRAVERSE (X)
ASED ON THE F	OLLOWING CONTROL:

◆ CORNER MONUMENT

O WITNESS MONUMENT

Fd TIES IN VOL4
PG1

BEARINGS ARE BASED ON:

(a)

OBSERVATION	SHEET	619
-------------	-------	-----

FIELD	BOOK _		PAGE #	¥					SHEET	a.
SHOW	A PLAN	VIEW	DRAWING	DEPICTING	THE	CORNER	MONUMENT	AND	SURRO	UND
							AND DEDT			

PLANNING & ZONING COMMITTEE ADOPTED THE ABOVE FORM ON 12/2/1982

CORNER CODE

X-2/

## NE619

(B)Describe any record evidence, monument evidence, occupational evidence, testimonial evidence or any other material evidence you considered, and whether the monument was found or placed.

1834 MILLER

PG 8 NORTH BETWEEN SECS 35 & 36

- 924 LEAVE ISLAND TIMBER ENTER MARSH S.E.
- 2310 LEAVE MARSH
- 2640 SET 1/4 SEC POST BUR OAK 18 S83E 31.02'; BUR OAK 10 S84W 60.72'
- **3227.4 WHITE OAK 14 IN DIA**
- 5280 COR OF SECS 25,26,35,36 SET POST BUR OAK 12 N68E 13.2'; BUR OAK 24 S15W 23.76' LAND LEVEL 2ND RATE TIMBER ON NORTH HALF OAK AND HICKORY OAK & HAZEL UNDERGROWTH
- 1869 LEE VOL 1 PG 339 FD STUMPS OF BTS VAR 5-11 2657.82 TO CENTER OF SEC 35

1871 COLLINS REMONUMENTATION NOTES

NORTH BETWEEN 35 & 36 VARIATION 6

- 2588.52 SET STONE FOR 1/4 SEC CORNER BY ROOTS OF WITNESS TREES CONTINUED NORTH SAME VARIATION
- 5179.68 INTERSECT SECTION LINE 2.64' WEST OF CORNER. SET STONE FOR CORNER SECS 25 & 26, 35,36 BY STUMP OF LINE TREE AND ROOTS OF WITNESS TREE. CORRECTED VARIATION 6-03
- 1957 SHIMEALLL #8506 2585.65' TO NE COR SEC 35, 2587.25' TO SE COR SEC 35
- 1964 BATTERMAN VOL 4 PG 1 FD & REFERENCED 5-17-62 SKETCH SHOWS COR 7.5' NORTH OF E/W CENTER PVMT. STONE MONUMENTS FD & REFERENCED BY R.H. BATTERMAN SR., JR. & W.T. BAPTIST 5/25/54 REFERENCES CHECKED BY COMBS & KERWIN 4-20-64.
- 1979 BARNES VOL 5 PG 536 ANGLE OF 89-37-23 @ SE COR SEC 35 FROM S 1/4 COR TO E 1/4 COR SEC 35, 2587.33' TO SE COR SEC 35, 2646.97' TO CENTER OF SEC 36, 5282.80' TO E 1/4 COR SEC 36, ANGLE OF 90-36-50 @ E 1/4 COR SEC 35 FROM SE TO W 1/4 CORNERS SEC 35, ANGLE OF 90-19-24 @ W 1/4 COR SEC 36 FROM CENTER OF SEC 36 TO SW COR SEC 36
- 1980 COMBS CSM 10 PG 48 1292.55' FROM NW COR SEC 36 TO W 1/16TH COR OF NW 1/4 SEC 36.
- 1996 KREBS CSM 19 PG 176 2585.02' TO NE COR SEC 35

FD L.S. IN MON. BOX 7.3' NORTH OF CENTER OF PVMT; 2.5' EAST OF N/S CENTER OF PVMT. SET MAG NAIL IN TOP OF L.S.

C) Was the corner restored through acceptance of (1) an obliterated evidence location, or, (2) a found perpetuated location?

ACCEPTED FOUND PERPETUATED LOCATION.

- (E) Was the corner reestablished through lost corner proportionate methods? If so, show the method, including the directions and distances to other public land survey corners used as evidence or used for proportioning the corner location.
- I, Donald Barnes, hereby certify that the corner location as identified by the corner code index was determined by me under my direction and control and that this U.S. Public Land Survey Monument Record is correct and complete to the best of my knowledge and belief.

seal

7-02-01

Number of included sheets **P** 

CORNER CODE X-21.

**A-E 7.08 REQUIREMENT**