

U.S. PUBLIC LAND SURVEY MONUMENT RECORD

For Public Land Survey Corners in:

WI ADMINISTRATIVE CODE A-E 7.08 REQUIREMENT

T. N., R. 11E

CORNER CODE INDEX

A	1	2	3	4	5	6	7	8	9	10	11	12	13	14	15	16	17	18	19	20	21	22	23	24	25
B																									
C	6																								
D		5																							
E																									
F																									
G	1																								
H		8																							
I			9																						
J																									
K																									
L	18																								
M		17																							
N			16																						
O				15																					
P					14																				
Q						13																			
R																									
S																									
T																									
U																									
V																									
W																									
X																									
Y																									
Z																									

NEWARK TWP

ROCK COUNTY WI

IF AVAILABLE
ROCK COUNTY COORDINATES PREFERRED

North _____ Elev. _____

East _____

Hor. Datum _____ Vert. Datum _____

LATITUDE _____ ELLIPS. HT. _____

LONGITUDE _____

GPS (X) _____ TRAVERSE (X) _____

BASED ON THE FOLLOWING CONTROL:

PLACE MONUMENT SYMBOL AT PROPER LOCATION ON ABOVE INDEX

CORNER MONUMENT

WITNESS MONUMENT

(a)

BEARINGS ARE BASED ON:

FIELD BOOK _____ PAGE # _____

SHEET 1 OF 1

SHOW A PLAN VIEW DRAWING DEPICTING THE CORNER MONUMENT AND SURROUNDING PHYSICAL FEATURES, INCLUDING THE EXCAVATION AREA AND DEPTH.

PLANNING & ZONING COMMITTEE ADOPTED THE ABOVE FORM ON 12/2/1982

CORNER CODE R-23

NE592

(B) Describe any record evidence, monument evidence, occupational evidence, testimonial evidence or any other material evidence you considered, and whether the monument was found or placed.

- 1834 MILLER MARCH PG 10 EAST RANDOM BETWEEN SECS 24 & 25
5296.5 INTERSECTED RANGE LINE 11.88' NORTH OF POST. LAND SAME
WEST CORRECTED BETWEEN SECS 24 & 25
1433.52 YELLOW OAK 10 IN
2647.92 SET 1/4 SEC POST BUR OAK 20 S73W 21.12'; BUR OAK 18 N27E 45.54'
4522.32 BUR OAK 8 IN DIA
5296.5 SEC COR
- 1851 MCVEAN VOL 1 PG 4 STATES NOTHING ABOUT MON. 2670.36' TO NW COR SEC 25, VAR 7 EAST 2659.8' TO CENTER OF SEC 25, & 5329.5' TO S 1/4 COR SEC 25
- 1863 LOCKE VOL 1 PG 185 FD BT SET STAKE SURROUNDED BY 3 HH. 2669.04' TO SW COR SEC 24
- 1871 COLLIN'S REMONUMENTATION NOTES
PG 136 EAST BETWEEN 24 & 25 ON OFFSET LINE 19.8' NORTH VARIATION 7
2680.92 INTERSECT 1/4 LINE 23.1' NORTH OF CORNER SET 1/4 STONE BY STUMPS OF WITNESS TREES. CORRECTED VARIATION 7-04 OCT 11, 1871
CONTINUED EAST VARIATION 7-15
5410.02 INTERSECT RANGE LINE 56.1' NORTH OF CORNER CORRECTED VARIATION 8-29
- 1911 KERCH #3202 & VOL 3 PG 68 MON. 2731.8' TO SE COR SEC 24. USED TO SUBDIVIDE SEC 25.
- 1961 BATTERMAN VOL 4 PG 91 DUG HOLE 20"X 16"X 3" FOUND NOTHING. NOTE: (N/S) SEC LINE RUNS ALONG THE WEST R/W OF KNUTSON ROAD. HOLE STARTS EAST OF N/S CENTER PVMT & EXTENDS WEST OF N/S WEST R/W FENCE ALONG CENTER OF E/W PVMT.
- 1978 BARNES VOL 5 PG 464 FORMER COUNTY SURVEYOR DUG & FD NOTHING. SET ON LINE WITH SE & SW CORNERS AT PRORATED DISTANCE WITH COLLINS REMONUMENTATION NOTES. SET ALUM. MON. 2679.82' TO SW COR SEC 24, 2727.98' TO SE COR SEC 24, WEST 1338' TO N/S FENCE LINE, & EAST 1360 TO N/S FENCE LINE. REFERENCED SAME. COR IS 1' NORTH OF SOUTH PVMT EDGE & 2' WEST OF N/S CENTER OF PVMT.
- 1988 LEE #12358 5348.44' TO N 1/4 COR SEC 24.
- 1992 LEE CSM 16 PG 179 1339.94' FROM S 1/4 COR SEC 24 WEST TO 1/16TH COR
- 1993 KREBS CSM 16 PG 297 2727.82' TO SE COR SEC 24.

FD ALUM. MON. WITH TOP BROKE OFF. USED STUD. 1' NORTH OF SOUTH PVMT EDGE & 2' WEST OF N/S PVMT .

C) Was the corner restored through acceptance of (1) an obliterated evidence location, or, (2) a found perpetuated location?

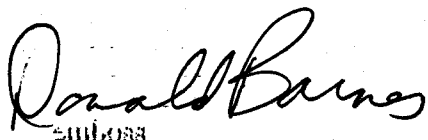
ACCEPTED FOUND PERPETUATED LOCATION.

D) Describe any material discrepancy between the location of the corner as restored or reestablished and the location of that corner as previously restored or reestablished by distance and direction. Show the discrepancy on the plan view drawing under (a), above. Show the distances between the corner as previously restored or reestablished and (1) the corner as restored or reestablished, and (2) to at least 4 of the witness monuments shown on the drawing in (a), above.

(E) Was the corner reestablished through lost corner proportionate methods? If so, show the method, including the directions and distances to other public land survey corners used as evidence or used for proportioning the corner location.

I, Donald Barnes, hereby certify that the corner location as identified by the corner code index was determined by me under my direction and control and that this U.S. Public Land Survey Monument Record is correct and complete to the best of my knowledge and belief.

seal


DONALD BARNES

Sheet 1 of 1

CORNER CODE **R-23**

7-03-01

A-E 7.08 REQUIREMENT