

# U.S. PUBLIC LAND SURVEY MONUMENT RECORD

For Public Land Survey Corners in:

WI ADMINISTRATIVE CODE A-E 7.08 REQUIREMENT

T. 1 N., R. 11 E

### CORNER CODE INDEX

|   |    |   |   |   |   |   |   |   |   |    |    |    |    |    |    |    |    |    |    |    |    |    |    |    |    |
|---|----|---|---|---|---|---|---|---|---|----|----|----|----|----|----|----|----|----|----|----|----|----|----|----|----|
| A | 1  | 2 | 3 | 4 | 5 | 6 | 7 | 8 | 9 | 10 | 11 | 12 | 13 | 14 | 15 | 16 | 17 | 18 | 19 | 20 | 21 | 22 | 23 | 24 | 25 |
| B |    |   |   |   |   |   |   |   |   |    |    |    |    |    |    |    |    |    |    |    |    |    |    |    |    |
| C | 6  |   |   |   |   |   |   |   |   |    |    |    |    |    |    |    |    |    |    |    |    |    |    |    |    |
| D |    |   |   |   |   |   |   |   |   |    |    |    |    |    |    |    |    |    |    |    |    |    |    |    |    |
| E |    |   |   |   |   |   |   |   |   |    |    |    |    |    |    |    |    |    |    |    |    |    |    |    |    |
| F |    |   |   |   |   |   |   |   |   |    |    |    |    |    |    |    |    |    |    |    |    |    |    |    |    |
| G | 1  |   |   |   |   |   |   |   |   |    |    |    |    |    |    |    |    |    |    |    |    |    |    |    |    |
| H |    |   |   |   |   |   |   |   |   |    |    |    |    |    |    |    |    |    |    |    |    |    |    |    |    |
| J |    |   |   |   |   |   |   |   |   |    |    |    |    |    |    |    |    |    |    |    |    |    |    |    |    |
| K |    |   |   |   |   |   |   |   |   |    |    |    |    |    |    |    |    |    |    |    |    |    |    |    |    |
| L | 18 |   |   |   |   |   |   |   |   |    |    |    |    |    |    |    |    |    |    |    |    |    |    |    |    |
| M |    |   |   |   |   |   |   |   |   |    |    |    |    |    |    |    |    |    |    |    |    |    |    |    |    |
| N |    |   |   |   |   |   |   |   |   |    |    |    |    |    |    |    |    |    |    |    |    |    |    |    |    |
| O |    |   |   |   |   |   |   |   |   |    |    |    |    |    |    |    |    |    |    |    |    |    |    |    |    |
| P | 19 |   |   |   |   |   |   |   |   |    |    |    |    |    |    |    |    |    |    |    |    |    |    |    |    |
| Q |    |   |   |   |   |   |   |   |   |    |    |    |    |    |    |    |    |    |    |    |    |    |    |    |    |
| R |    |   |   |   |   |   |   |   |   |    |    |    |    |    |    |    |    |    |    |    |    |    |    |    |    |
| S |    |   |   |   |   |   |   |   |   |    |    |    |    |    |    |    |    |    |    |    |    |    |    |    |    |
| T | 30 |   |   |   |   |   |   |   |   |    |    |    |    |    |    |    |    |    |    |    |    |    |    |    |    |
| U |    |   |   |   |   |   |   |   |   |    |    |    |    |    |    |    |    |    |    |    |    |    |    |    |    |
| V |    |   |   |   |   |   |   |   |   |    |    |    |    |    |    |    |    |    |    |    |    |    |    |    |    |
| W |    |   |   |   |   |   |   |   |   |    |    |    |    |    |    |    |    |    |    |    |    |    |    |    |    |
| X | 31 |   |   |   |   |   |   |   |   |    |    |    |    |    |    |    |    |    |    |    |    |    |    |    |    |
| Y |    |   |   |   |   |   |   |   |   |    |    |    |    |    |    |    |    |    |    |    |    |    |    |    |    |
| Z |    |   |   |   |   |   |   |   |   |    |    |    |    |    |    |    |    |    |    |    |    |    |    |    |    |

NEWARK TWP

ROCK COUNTY WI

IF AVAILABLE  
ROCK COUNTY COORDINATES PREFERRED

North \_\_\_\_\_ Elev. \_\_\_\_\_

East \_\_\_\_\_

Hor. Datum \_\_\_\_\_ Vert. Datum \_\_\_\_\_

LATITUDE \_\_\_\_\_ ELLIPS. HT. \_\_\_\_\_

LONGITUDE \_\_\_\_\_

GPS (X) \_\_\_\_\_ TRAVERSE (X) \_\_\_\_\_

BASED ON THE FOLLOWING CONTROL:

PLACE MONUMENT SYMBOL  AT PROPER LOCATION ON ABOVE INDEX

 CORNER MONUMENT

 WITNESS MONUMENT

(a)

BEARINGS ARE BASED ON:

FIELD BOOK \_\_\_\_\_ PAGE # \_\_\_\_\_

SHEET 1 OF 2

SHOW A PLAN VIEW DRAWING DEPICTING THE CORNER MONUMENT AND SURROUNDING PHYSICAL FEATURES, INCLUDING THE EXCAVATION AREA AND DEPTH.

PLANNING & ZONING COMMITTEE ADOPTED THE ABOVE FORM ON 12/2/1982

CORNER CODE V23

NE612

(B) Describe any record evidence, monument evidence, occupational evidence, testimonial evidence or any other material evidence you considered, and whether the monument was found or placed.

1834 MILLER MARCH 8 PG 9 EAST RANDOM BETWEEN SECS 25 & 36  
5281.98 INTERSECTED RANGE LINE 3.3' LAND 2ND RATE GENTLY  
ROLLING TIMBER OAK & HICKORY. SOIL SANDY LOAM  
WEST MARKED BACK

848.76 BUR OAK 15 DIA

2640.66 SET 1/4 SEC POST BUR OAK 10 N49E 159.72'; BUR OAK 12 S84E  
278.52'

5281.98 SEC COR

1851 MCVEAN VOL 1 PG 4 2640.00' TO NE COR SEC 36, 2669.70' VAR 7 EAST TO  
CENTER OF SEC 25, 5329.5' TO N 1/4 COR SEC 25

1852 MCVEAN VOL 1 PG 12 2630.1' TO NW COR SEC 36 & 5280' TO S 1/4 COR  
SEC 36

1857 MCVEAN #3203 VAR 7 2669.70' TO CENTER OF SEC 25

1871 COLLIN'S REMONUMENTATION NOTES

PG 134 EAST BETWEEN 25 & 36 VAR 6-30

2649.24 INTERSECTED 1/4 LINE 7.92' SOUTH OF CORNER SET 1/4 STONE  
IN PLACE OF STAKE SET BY MESSER. CORRECTED  
VARIATION 6-19'.

CONTINUED EAST VARIATION 7

5286.6 SECTION COR.

1881 LEE #6802 VAR 6-30 2622.18 TO NE COR SEC 36

1881 LEE VOL 2 PG 317 VAR 6-30 2622.18' TO NE COR SEC 36, 2625.48' TO  
CENTER OF SEC 36, & @ W 1/16TH COR OF NE 1/4 SEC 36 FD STAKE SET  
BY MESSER -CORRECT

1911 KERCH VOL 3 PG 68 FD MON. PARTLY OUT OF THE GROUND. LOWERED  
SAME. USED TO SUBDIVIDE SEC 25

1957 SHIMEALL #8506 2644.6' TO NW COR SEC 36 & 2626.7' TO NE COR SEC 36

1965 BATTERMAN VOL 4 PG 232 FOUND CUT STONE MON. DESTROYED ORIG  
RESET C.I. HARRISON 4-30-72 T.N. SKETCH SHOWS NEAR FENCE INT. ON  
SOUTH SIDE OF MILL POND RD. REFERENCED SAME. FD 2" PIPE BY  
SHIMEALL AT CENTER OF SEC 36.

1972 BATTERMAN VOL 4 PG 232 DESTROYED ORIG RESET C.I. HARRISON 4-  
30-72 T.N. SKETCH SHOWS NEAR FENCE INT. ON SOUTH SIDE OF MILL  
POND RD.

1975 WPL CENTER OF SEC 36 N/S 185,008.33; E/W 2,232,033.97

1981 TOWNSEND CSM 10 PG 336 2642.54' TO NW COR SEC 36

FD C.I. WITH CARSONITE ON SOUTH SIDE OF RD IN LAWN.

C) Was the corner restored through acceptance of (1) an obliterated evidence location, or, (2) a found  
perpetuated location?

ACCEPTED FD PERPETUATED LOCATION.

I, Donald Barnes, hereby certify that the corner location as identified by the corner code index  
was determined by me under my direction and control and that this U.S. Public Land Survey  
Monument Record is correct and complete to the best of my knowledge and belief.

<sup>seal</sup>  
  
<sub>emboss</sub>

sheet 1 of 2

7-11-01

CORNER CODE V-23

A-E 7.08 REQUIREMENT

*Donald B. Baus*  
 EMBOSSED SEAL

7-11-01

N 1/4 COR  
 SEC 36  
 NEWARK TWP  
 T1N R11E

C.I.  
 /CARSONITE  
 SOUTH SIDE OF  
 RD IN LAWN

2" PIPE  
 CENTER OF  
 SEC 36

STA 827  
 3/4X24" REROD/  
 NORTH SIDE OF  
 3'- SOUTH SIDE OF  
 FENCE.

2626.48  
 N115.814E

N84-53-25E  
 N87-47-43E  
 N118.019  
 N118.814E

29,242'  
 S29-36-38E  
 WATER TANK

S46-19-23E 3726.82

S0-11-10W 2601.14

N1-37-08W 2808.75

DISK IN CONC.  
 GPS MON. 313A  
 NORTH SIDE OF RD



N89-25-09E 2703.98

LAWRENCE AVE.

DISK IN CONC.  
 GPS MON. 313S  
 SOUTH SIDE OF  
 STH "81"

MILL POND RD

STH 81

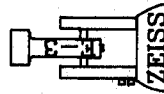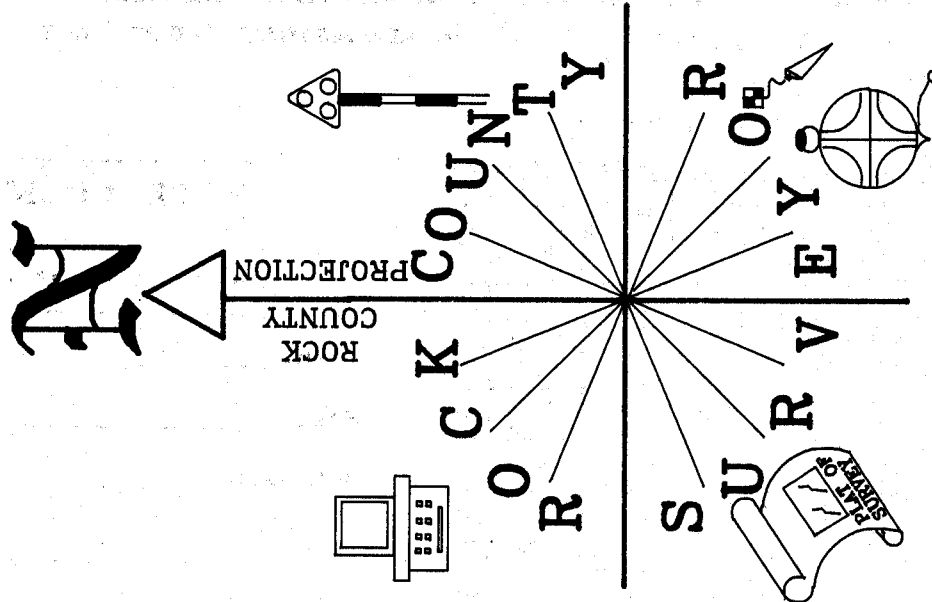

NOT TO SCALE  
 OBSERVATION SHEET 827