U.S.

PUBLIC LAND SU MONUMENT RECORD SURVEY

• • •		R/	—⊏ ODE INI)FY		
23456					1 22 23 24 25	NEWARK TWP
+	\prod					ROCK COUNTY WI
6						IF AVAILABLE ROCK COUNTY COORDINATES PERFERRED
	a	4	امد		10	1000 00011 0001210120 210 210 210
						North Elev
18	4	10	45	A.	13	East
						Hor. Datum Vert. Datum
19	20	2	22	23	24	LATITUDEELLIPS.
20	9	08	01	6	Ĉ	LONGITUTE
	4	4	4		9	GPS (X) TRAVERSE (X)
3	32	33	34	35	98	BASED ON THE FOLLOWING CONTROL:
	山山					

(a)

BEARINGS ARE BASED ON:

OBSERVATION SHEET 611	
FIELD BOOKPAGE #SHEE	$T = \int 0F = Z$
SHOW A PLAN VIEW DRAWING DEPICTING THE CORNER MONUMENT AND SUR PHYSICAL FEATURES, INCLUDING THE EXCAVATION AREA AND DEPTH.	ROUNDING
PLANNING & ZONING COMMITTEE ADOPTED THE ABOVE FORM ON 12/2/1982	
CODNED CODI	11-2-1

NE611

(B)Describe any record evidence, monument evidence, occupational evidence, testimonial evidence or any other material evidence you considered, and whether the monument was found or placed.

1834 MILLER MARCH 8

PG 14

EAST RANDOM BETWEEN 26 & 35

1320 ENTER LOW GROUND C. SOUTH

LEAVE SAME 2772

INTERSECT SEC. LINE 9.9' SOUTH POST. LAND 2ND RATE LEVEL OAK 5266.8 **TIMBER**

WEST CORRECTED BETWEEN SECS 26 & 35

BUR OAK 12 IN 356.4

SET 1/4 SEC POST BUR OAK 6 IN S89E 5.35', BUR OAK 10 N40E 176.88' 2633.4

YELLOW OAK 5 3973.2

4900.5 **YELLOW OAK 12**

5266.8 SEC COR

PG 9 NORTH BETWEEN 25 & 26

5287.92 BUR OAK 14 IN DIA

2640 SET 1/4 SEC POST BUR OAK 18 IN S6E 21.12'; BUR OAK 18 N54W 13.86'

3428.7 BUR OAK 6 IN DIAMETER

4988.28 BUR OAK 10 IN DIAMETER

5280 SET POST COR SECS 23,24,25,26 BUR OAK 12 IN N17E 7.92'; YELLOW OAK 30 S50W 21.78' LAND GENTLY ROLLING 2ND RATE TIMBER OAK & HICKORY OAK HAZEL & HICKORY U.G. PRAIRIE GRASS RED ROOT PG 9 EAST RANDOM BETWEEN SECS 25 & 36

5281.98 INTERSECTED RANGE LINE 3.3' LAND 2ND RATE GENTLY ROLLING TIMBER OAK & HICKORY. SOIL SANDY LOAM

WEST MARKED BACK

848.76 BUR OAK 15 DIA

2640.66 SET 1/4 SEC POST BUR OAK 10 N49E 159.72'; BUR OAK 12 S84E 278.52' 5281.98 SEC COR

PG 8 NORTH BETWEEN SECS 35 & 36

924 LEAVE ISLAND TIMBER ENTER MARSH S.E.

2310 LEAVE MARSH

2640 SET 1/4 SEC POST BUR OAK 18 S83E 31.02'; BUR OAK 10 S84W 60.72

3227.4 WHITE OAK 14 IN DIA

5280 COR OSF SECS 25,26,35,36 SET POST BUR OAK 12 N68E 13.2'; BUR OAK 24 S15W 23.76' LAND LEVEL 2ND RATE TIMBER ON NORTH HALF OAK AND HICKORY OAK & HAZEL UNDERGROWTH

1852 MCVEAN VOL 1 PG 12 2630.1 TO N 1/4 COR SEC 36

LEE VOL 1 PG 339 SET BR OAK STAKE WITH HH N & S (FOUND STUMPS OF BTS) 1869 VAR 5-30 2641.32 TO N 1/4 COR SEC 35

1871 COLLIN'S REMONUMENTATION NOTES

PG 135

NORTH BETWEEN 25 & 26 VARIATION 7

2704.68 INTERSECT 1/4 LINE 1.54' WEST OF CORNER SET 1/4 STONE BY STUMPS OF WITNESS TREES. CORRECTED VARIATION 7-02 CONTINUED NORTH VARIATION 7-15

5377.02 INTERSECT SECTION LINE 17.16' WEST OF CORNER SET STONE FOR CORNER 23,24,25,26 BY STUMPS OF WITNESS TREES CORRECTED **VARIATION 7-38**

PG 150

EAST BETWEEN 26 & 35 VARIATION 4-15

2641.32 SET 1/4 STONE BY STUMP OF WITNESS TREE

CONTINUED EAST VARIATION 5-30

5289.9 SECTION CORNER

PG 133

NORTH BETWEEN 35 & 36 VARIATION 6

2588.52 SET STONE FOR 1/4 SEC CORNER BY ROOTS OF WITNESS TREES. CONTINUED NORTH SAME VARIATION

SHEET 1 OF 32

U.S.


LAND **PUBLIC** SURVEY MONUMENT RECORD

For Public Land Survey Corners in:

WI ADMINISTRATIVE CODE A-E 7.08 REQUIREMENT

、 T. ∠N., R. _//_E

CORNER CODE INDEX

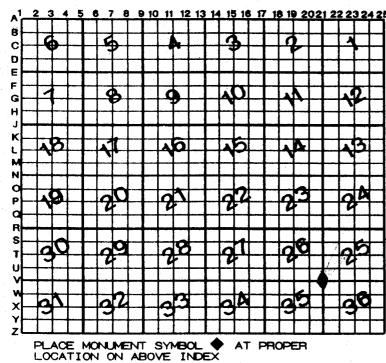

NEWARK ROCK COUNTY WI

IF AVAILABLE ROCK COUNTY COORDINATES PERFERRED

Elev.

East			
		And the second	
Hor.	Datum	Vert. Datum	

LATITUDE _ ELLIPS. HT.

LONGITUTE

GPS (X) TRAVERSE (X)

BASED ON THE FOLLOWING CONTROL:

♦CORNER MONUMENT

O WITNESS MONUMENT

North

(a)

Fd TIES IN VOL 4 PJ

BASED ON BEARINGS ARE

					-
FIELD	BOOK	PAGE #		SHEET	OF
		***************************************	 DENER MONUMEN	T AND SURROUNDING	
		INCLUDING THE E			

PLANNING & ZONING COMMITTEE ADOPTED THE ABOVE FORM ON 12/2/1982

5179.68 INTERSECT SECTION LINE 2.64' WEST OF CORNER. SET STONE FOR CORNER SECS 25 & 26, 35,36 BY STUMP OF LINE TREE AND ROOTS OF WITNESS TREE. CORRECTED VARIATION 6-03

PG 134

EAST BETWEEN 25 & 36 VAR 6-30

2649.24 INTERSECTED 1/4 LINE 7.92' SOUTH OF CORNER SET 1/4 STONE IN PLACE OF STAKE SET BY MESSER. CORRECTED VARIATION 6-19'.

CONTINUED EAST VARIATION 7

5286.6 SECTION COR.

1957 SHIMEAL #8506 2644.6 TO S 1/4 COR SEC 25, 2585.65 TO W 1/4 COR SEC 36

1964 BATTERMAN VOL 4 PG 1 2645.45 TO S 1/4 COR SEC 26 & REFERENCED CORNER STATEMENT IN MIDDLE OF DRAWING, "STONE MONUMENTS FD & REFERENCED BY R.H. BATTERMAN SR., JR. & W.T. BAPTIST 5-25-54. REF. CHECKED BY COMBS & KERWIN 4-20-64"

1980 COMBS CSM 10 PG 48 1292.55 SOUTH TO 1/16TH COR

1981 TOWNSEND CSM 10 PG 336 2642.54 TO S 1/4 COR SEC 25

1994 KREBS CSM 17 PG 209 2645.40 TO S 1/4 COR SEC 26

1996 KREBS CSM 19 PG 176 2585.02 TO W 1/4 COR SEC 36

1998 KREBS CSM 21 PG 125 2697.73 TO W 1/4 COR SEC 25

FD 1/2" PIN. 0,2' DEEP

C) Was the corner restored through acceptance of (1) an obliterated evidence location, or, (2) a found perpetuated location?

ACCEPTED FD PERPETUATED LOCATION.

- D) Describe any material discrepancy between the location of the corner as restored or reestablished and the location of that corner as previously restored or reestablished by distance and direction. Show the discrepancy on the plan view drawing under (a), above. Show the distances between the corner as previously restored or reestablished and (1) the corner as restored or reestablished, and (2) to at least 4 of the witness monuments shown on the drawing in (a), above.
- (E) Was the corner reestablished through lost corner proportionate methods? If so, show the method, including the directions and distances to other public land survey corners used as evidence or used for proportioning the corner location.
- I, Donald Barnes, hereby certify that the corner location as identified by the corner code index was determined by me under my direction and control and that this U.S. Public Land Survey Monument Record is correct and complete to the best of my knowledge and belief.

geal

emboss

2-07-01

SHEET 2 OF \$ 2

CORNER CODE V-21

A-E 7.08 REQUIREMENT