

Paper weight-110# (minimum)

Black nonfading ink required

U.S. PUBLIC LAND SURVEY MONUMENT RECORD

For Public Land Survey Corners In:
T. 3 N. R. 11 E. 4th P.M.

WI ADMINISTRATIVE CODE A-E 7.08 REQUIREMENT
REV 10/23/2004 USMONREC.DWG

CORNER CODE INDEX

	1	2	3	4	5	6	7	8	9	10	11	12	13	14	15	16	17	18	19	20	21	22	23	24	25		
A																											A
B																											B
C																											C
D																											D
E																											E
F																											F
G																											G
H																											H
J																											J
K																											K
L																											L
M																											M
N																											N
O																											O
P																											P
Q																											Q
R																											R
S																											S
T																											T
U																											U
V																											V
W																											W
X																											X
Y																											Y
Z																											Z

1 2 3 4 5 6 7 8 9 10 11 12 13 14 15 16 17 18 19 20 21 22 23 24 25
PLACE MONUMENT SYMBOL AT PROPER
LOCATION ON ABOVE INDEX

CENTER TWP

ROCK COUNTY WI

IF AVAILABLE
ROCK COUNTY COORDINATES PREFERRED

North _____ Elev. _____

East _____

Hor. Datum _____ Vert. Datum _____

LATITUDE _____ ELLIPS. HT. _____

LONGITUDE _____

NAD83(91) _____ NETWORK ADJ. YR _____

GPS (X) _____ TRAVERSE (X) _____

BASED ON THE FOLLOWING CONTROL:

CORNER MONUMENT

WITNESS MONUMENT

(a)

BEARINGS ARE BASED ON: _____

FIELD BOOK _____ PAGE # _____

SHEET 1 OF 3

SHOW A PLAN VIEW DRAWING DEPICTING THE CORNER MONUMENT AND SURROUNDING
PHYSICAL FEATURES, INCLUDING THE EXCAVATION AREA AND DEPTH.

PLANNING & ZONING COMMITTEE ADOPTED THIS FORM ON 12/2/1982

CORNER CODE L-25

CE560

(B) Describe any record evidence, monument evidence, occupational evidence, testimonial evidence or any other material evidence you considered, and whether the monument was found or placed.

- 1860 RUGER VOL 1 PG 130 STATES NOTHING ABOUT MON. USED TO SUBDIVIDE SEC 18. VAR 7-45 2453.88 TO CEN OF SEC 18, VAR 7-45 5085.30 TO E 1/4 COR SEC 18.
- 1886 RUGER VOL 2 PG 273 FD OLD STAKE & STUMP OF S.W. BT & REMAINS OF STUMP OF NW BT SET IN PLACE OF OLD STAKE HH STONE 13X12X9 & SURROUNDED IT BY 4 HH STONES. SUBDIVIDED SEC 18. E/W 1/4 LINE OF SEC 18 IS VAR 4-5
- 1974 COMBS CSM 4-86 FD HH SURROUNDED BY HH. SOUTH ALONG SEC LINE 15.00 THENCE ANGLE LEFT OF 90-00-00 33.00 TO PIPE POB. LOT IS 150.00 WIDE.
- 1974 LEE VOL 5 PG 30 SET ALUM. MON & REF. SAME.
- 1974 COMBS CSM 4-152 NOTE: "SURVEY WAS RECORDED BACAUSE OF MISTAKE IN FINAL DISTANCE IN THE DESCRIPTION". CSM IS CSM 4-86
- 1987 BARNES L-1 FB#1 PG 57 & FB #2 PG 20 FD ALUM MON & SET 1/2X24 REROD FOR REFERENCE TIES. NAD27 911.4X 264,803.24; 2,233,566.82
- 1990 COMBS CSM 14-287 FD ALUM. SOUTH ALONG SEC LINE 792.0 TO POB. FD ALUM @ SE COR SEC 13 & CI @ W 1/4 COR SEC 13. N89-30-20W TO W 1/4 COR SEC 13.
- 1991 SCHROEDER CSM 15-71 STATES NOTHING ABOUT MON.
- 1991 SCHROEDER #11880 STATES NOTHING ABOUT MON. ANGLE 89-55-XX @ SE COR SEC 13 FROM S 1/4 COR SEC 13 TO E 1/4 COR SEC 13.
- 1993 DERPINGHAUS CSM 17-61 FD ALUM. NO-05-28E ALONG SEC LINE 237.00 TO A R/R SPIKE BEING THE NE COR OF SURVEY. FD ALUM @ NE COR SEC 13. N89-30-20W 40.00 ALONG E/W 1/4 LINE TO POB
- 1994 COMBS CSM 18 PG 60 & 61 CONC. MON.
- 1994 L-1(1) BARNES FD ALUM MON WITH TOP BROKE OFF. ROAD CONSTRUCTION WILL DISTURB AREA.
- 1998 THOM MAP #14321 FD IRON PIN MON. NO-50-45W 567.50 TO NE PROPERTY CORNER, S89-45-23W 279.02 ALONG E/W 1/4 LINE TO POB.
- 1998 THOM MAP #14327 FD IRON PIN MON. NO-50-45W ALONG SEC LINE 567.50 TO NE PROPERTY CORNER. S89-45-23W 2693.80 TO SET 3/4X24 PIN @ CENTER OF SEC 13.
- 1998 THOM MAP #14328 FD IRON PIN MONUMENT.
- 1999 LATHROP CSM 22-124 SPIKE NAIL. SO-44-55E 2649.10 TO PK @ SW COR SEC 18.
- 2000 THOM MAP #14326 FD IRON PIN MON.
- 2001 LATHROP CSM 24-394 FD SPIKE NAIL. N00-00-05W ALONG SEC LINE TO FD DOT DISK @ NW COR SEC 18. S89-14E FROM NW COR SEC 18 TO FD DOT DISK N 1/4 COR SEC 18
- 2003 COMBS "HAWK'S GLENN" P32 PG 616 FD 3/4 IRON BAR @ E 1/4 COR SEC 13. SOUTH 2649.07 TO PK @ SE COR SEC 13. ANGLE 89-56-12 @ SE COR SEC 13 FROM PIPE @ S 1/4 COR SEC 13 TO IRON BAR @ E 1/4 COR SEC 13
- 2007 LATHROP MAP #15914 LOT 1 OF CSM VOL 4 PG 152

FD REROD IN DISOLVING ALUM. MON.

David Kanes
9/25/08

CE560

C) Was the corner restored through acceptance of (1) an obliterated evidence location, or, (2) a found perpetuated location?

ACCEPTED FOUND PERPETUATED LOCATION.

3

D) Describe any material discrepancy between the location of the corner as restored or reestablished and the location of that corner as previously restored or reestablished by distance and direction. Show the discrepancy on the plan view drawing under (a), above. Show the distances between the corner as previously restored or reestablished and (1) the corner as restored or reestablished, and (2) to at least 4 of the witness monuments shown on the drawing in (a), above.

NONE

(E) Was the corner reestablished through lost corner proportionate methods? If so, show the method, including the directions and distances to other public land survey corners used as evidence or used for proportioning the corner location.

NO

I, **Donald Barnes**, hereby certify that the corner location as identified by the corner code index was determined by me under my direction and control and that this U.S. Public Land Survey Monument Record is correct and complete to the best of my knowledge and belief.

Seal
Donald
Embloss
Barnes
9/25/08


SHEET 2 OF 3

CORNER CODE **L-25**

A.E. 7.08 REQUIREMENT

N77-03-18W 10,644' ANT
 N75-56-57E FAR CELL
 N80-02-26E 40,835' CABLE ANT
 E 1/4 COR SEC 13
 S70-30-28E 16,110 ANT
 S70-16-40E 16,021' ANT

E 1/4 COR SEC 13 & W 1/4 COR SEC 18
 CENTER TWP JANESVILLE TWP
 T3N R11E T3N R12E
 FIELD BOOK #2 PG 76
 OBSRVATION SHEET #560CE

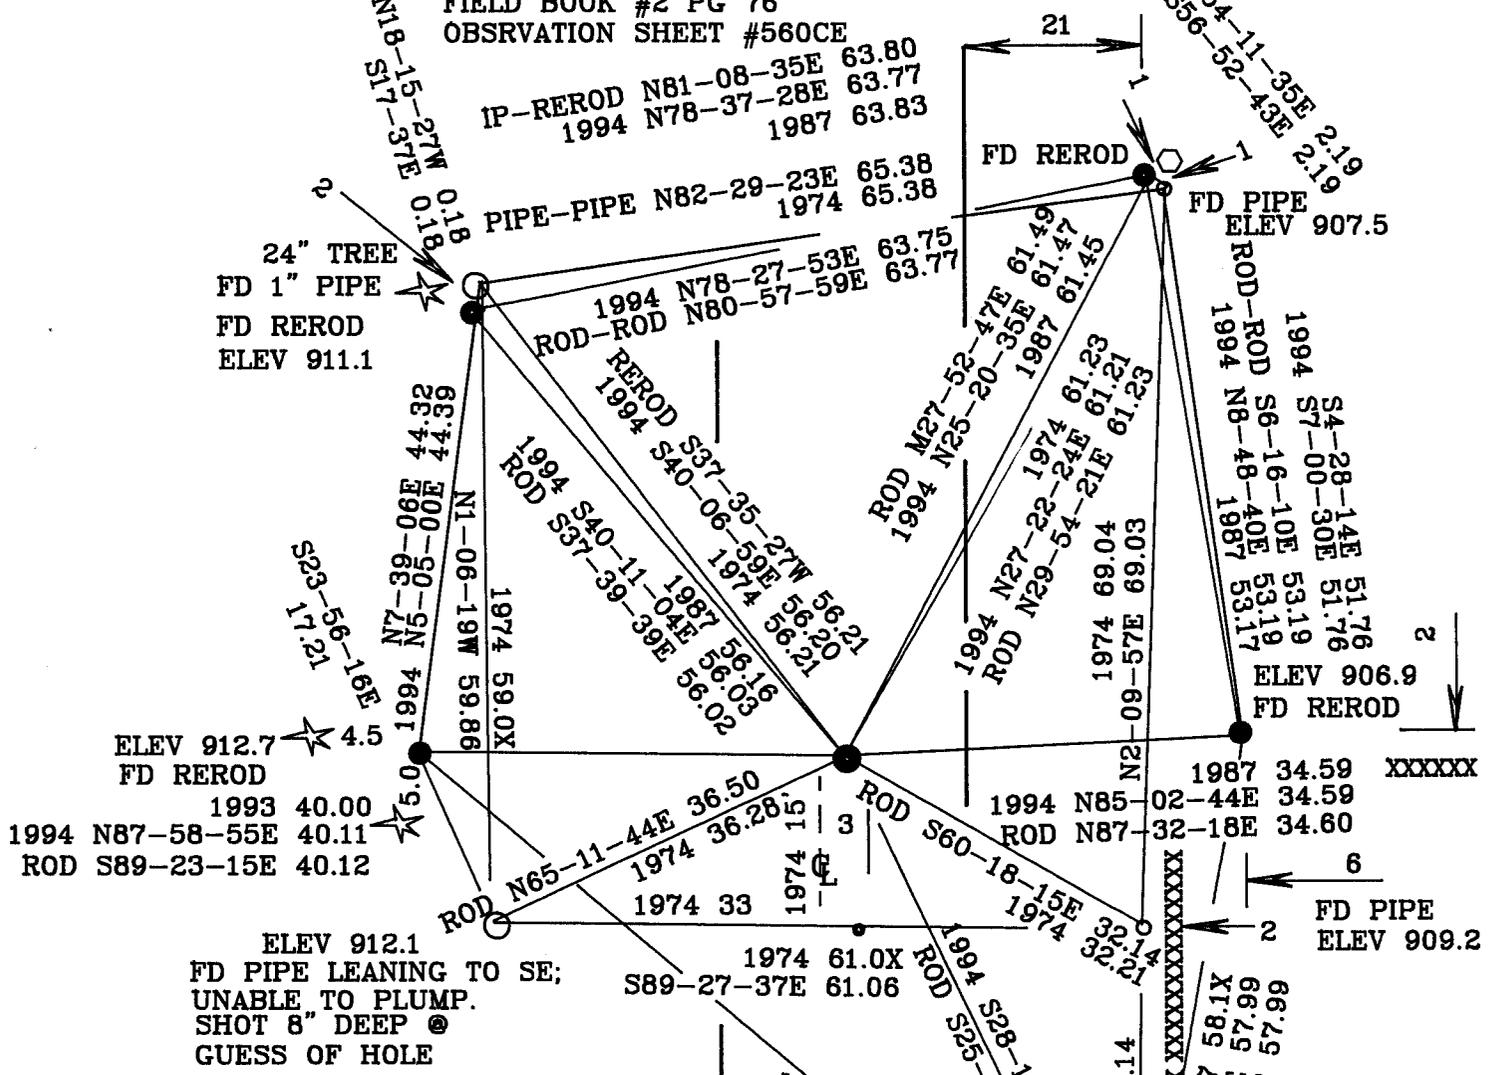

- FD 3/4 REROD
- FD 1" IRON PIPE
- FD 3/4 REROD IN DISSOLVING ALUM. MON. TOP OF REROD IS 0.' BELOW PVMT ELEV 911.4

EMBOSSSED SEAL

Don Barnes
 9/25/08

CTH H

SHEET 3 OF 3

L-75

POT CONTRACTOR placed ALUM MON in Aug 2009, WITH OUR A TIE CROSS LOCATION MARK. IT checked. Don Barnes