
Paper weight- 32# 25% Rag Ledger (minimum)

Black nonfading in required

SUPMEY BLIC RECORD MONUMENT

| For | Public Land | Survey | Corners | in | the |
|-----|-------------|--------------|---------|----|-----|
| | T. 3 N., | R. <u>//</u> | _E | | |

CORMER CODE INDEX

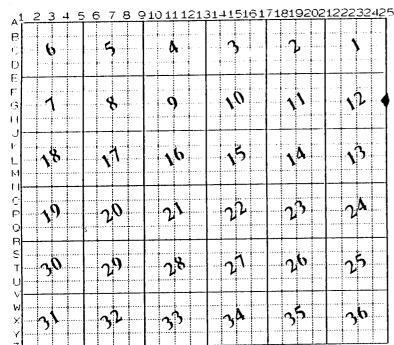

| CENTER | | | | I |
|--------|--------|----|--|---|
| ROCK | COUNTY | WI | | |

| BOCK COMMI | TE AVAILABLE Y COORDINATES PERLERRED | |
|------------------|--|--|
| North | Elev. | |
| East | AND THE PROPERTY OF THE PROPER | |
| Hor. Datum | Vert. Datum | |
| GPS (X) | TRAVERSE (X) | |
| BASED ON THE FOL | LOWING CONTROL: | |
| | | |
| | | |

PLACE MONUMENT SYMBOL & LOCATION ON ABOVE INDEX

CORNER MONUMENT

O WITHESS MONUMENT

BEARINGS ARE BASED ON:


(a)

FIELD BOOK PAGE #

SHOW A PLAN VIEW DRAWING DEPICTING THE COPIER MONDMENT AND SUPPOUNDING PHYSICAL FEATURE FOLLOWING CHARACTERISTICS: 1) HAVE A LEAST TWO PREDETERMINED BRIEAK-OFF POINTS. 27 31 MUST BE EXTENDABLE. 4) THE CAP IS TISORIEDED TROCK COUNTY SURVEY MONAMENT. PENALTY 4' MINIMINAM AND ESSO THE AREAS MARRE GROUND WATER IS SWITHIN ONE FOUR OF THE SUPPACE, DURABLE, DISTRICT MONDMENT MAY BE USED. COMBENS SHALL BE REFERENCED WITH AT LEAST 4 DL STONE, IRON OR OTHER EQUÂLLY DURABLE MATERIAL EXCEPT WOOD. DESCRIBE THE CORNER AND THE SHEET \angle OF \angle

PLAINTING & ZONIER COMMITTEE ADOPTED THE ABOVE FORM ON 12/2/1985 WI ADMINISTRATIVE CODE A-E 7.08 REQUIRENEITH

CORNER CODE

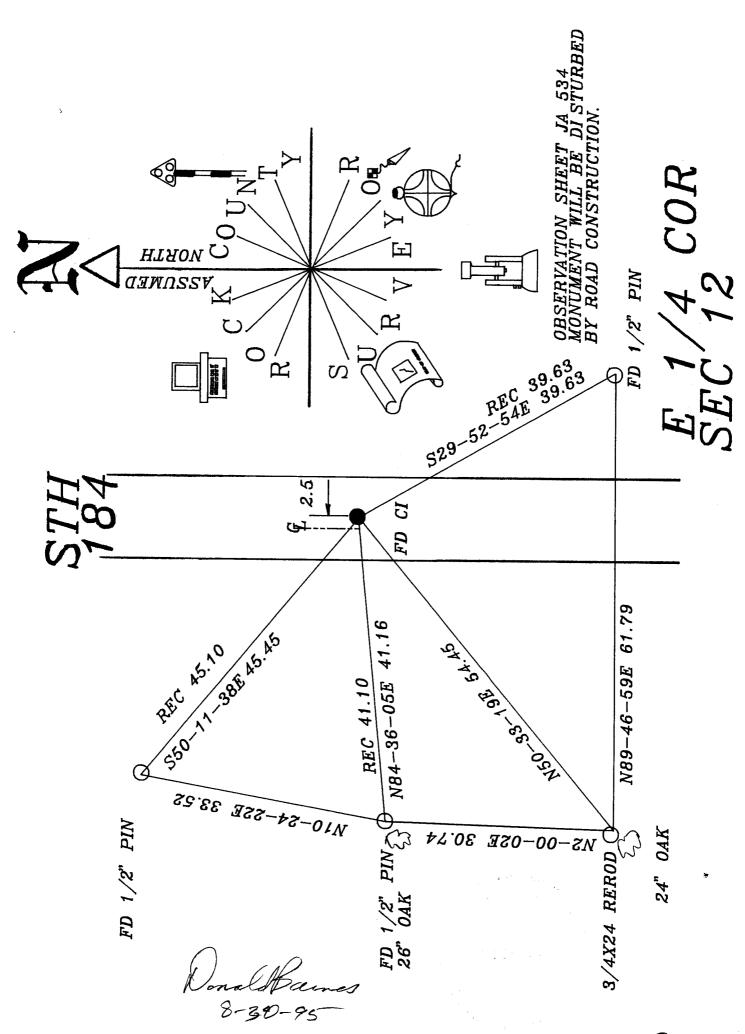

- (B) Describe any record evidence, monument evidence, occupational evidence, testimonial evidence or any other material evidence you considered, and whether the monument was found or placed.
 FOUND MONUMENT AS SHOWN IN DRAWING.
- C) Was the corner restored through acceptance of (1) an obliterated evidence location, or, (2) a found perpetuated location?
 THE MONUMENT WILL BE DISTURBED BY ROAD CONSTRUCTION. CORNER PERPETUATED AS FOUND.
- D) Describe any material discrepancy between the location of the corner as restored or reestablished and the location of that corner as previously restored or reestablished by distance and direction. Show the discrepancy on the plan view drawing under (a), above. Show the distances between the corner as previously restored or reestablished and (1) the corner as restored or reestablished, and (2) to at least 4 of the witness monuments shown on the drawing in (a), above.
- (E) Was the corner reestablished through lost corner proportionate methods? If so, show the method, including the directions and distances to other public land survey corners used as evidence or used for proportioning the corner location.

I, Donald Barnes, hereby certify that the corner points as identified by the corner code index were, in a field survey on, JULY 31,1995, established, re-established, monumented, re-monumented, recovered or restored as expressed below and in conformance with the regulations and rules as required in the current manual of survey instructions of the United States Department of Interior, Bureau of Land Management.

| | | COUNTY SURVEYOR FILING DATA |
|---------------------------|----------------|--------------------------------------|
| seal | | Date of computer entry |
| | ¹ 3 | Date microfilmed |
| Donald Lames | 511 - FF | Number of included sheetsCORNER CODE |
| EMBOSS LAND SURVEYOR SEAL | A-E 7.08 | REQUIREMENT |

8-30-95