Paper weight- 32# 25% Rag Ledger (minimum)


Black nonfading introduced

U.S.

SURVEY "UBLIC MONUMENT RECORD

For Public Land Survey Corners in the T.3_N., R. /2_E

CORNER CODE INDEX

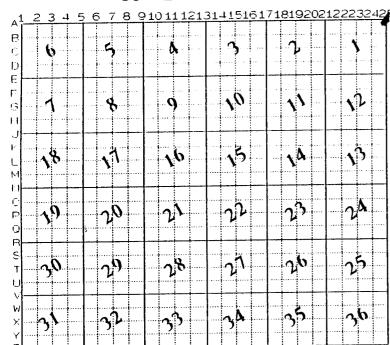

| CEN | TER | TWI |
|-----|--------|-----|
| | COUNTY | WI |

| TE AVAILABLE ROCK COUNTY COORDINATES PERLERRED | | | |
|--|--------------------|--|--|
| | Elev. | | |
| East | | | |
| Hor. Datum | n Vert. Datum | | |
| GPS (X) | TRAVERSE (X) | | |
| BASED ON THE | FOLLOWING CONTROL: | | |
| | | | |
| | | | |

PLACE MONUMENT SYMBOL & LOCATION ON ABOVE INCEX

CORNER MONUMENT


O WITHESS MONUMENT

BEARINGS ANE BASHO ON:

(a)

| FIELD BOOK | | | FEATURES, INCLUDING THE EX | XCAVATION AREA AND DEPTH | THE CORNER M | CHILDENT SHALL HAVE |
|----------------------------------|---|--|--|--------------------------|---------------|----------------------|
| THE FOLLOWING CHARACTERISTICS: | I HAVE A LEAST TWO PREDE | FRMINED BREAK-OFF FOILIS | ALTY COR DISTINGUIS MARKE | ER 5) OR AN EXISTING C | IT LIMESTONE. | AN IRON PIPE 1 1/2'Y |
| 4' BEINIAUM MAY BE USED 14 AFEAS | S WHERE GROUND WATER IS WILL BE USED. CORHERS SHALL BE | THIN ONE FOOT OF THE SLEET REFERENCED WITH AT LEAST | FACE, IF THE COMMEN IS DO F 4 DURABLE WITNESS MONUM | ENTS. WITHESS MONUMENTS. | SHALL BE MADE | OF CONORETE, NATURAL |
| STONE THOSE OR OTHER EQUÂLLY DUR | ABLE MATERIAL E-CEPT WOOD | DESCRIBE THE CORNER AND | THE WITHESS MONUMENTS. | | | / _ |

PLAINING & ZONING COMMITTEE ADOPTED THE ABOVE FORM ON 12/2/1982 MT ADMINISTRATIVE CODE A-E 7.08 REQUIREMENT

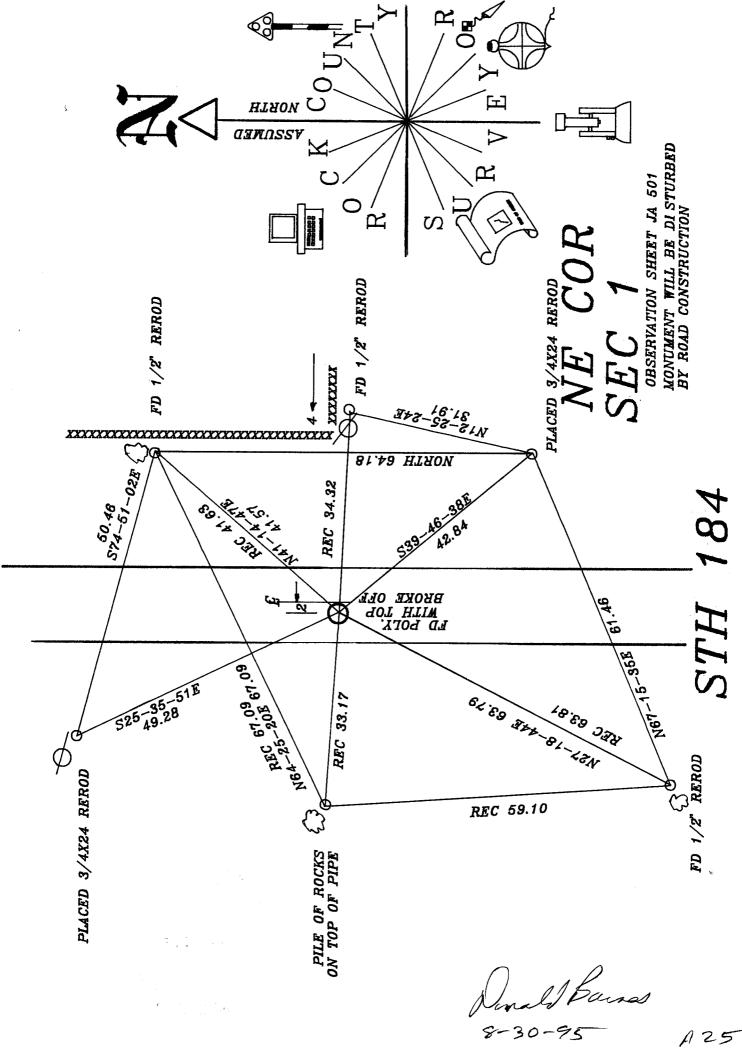

- (B) Describe any record evidence, monument evidence, occupational evidence, testimonial evidence or any other material evidence you considered, and whether the monument was found or placed. FOUND MONUMENT AS SHOWN IN DRAWING.
- C) Was the corner restored through acceptance of (1) an obliterated evidence location, or, (2) a found perpetuated location?
 THE MONUMENT WILL BE DISTURBED BY ROAD CONSTRUCTION. CORNER PERPETUATED AS FOUND.
- D) Describe any material discrepancy between the location of the corner as restored or reestablished and the location of that corner as previously restored or reestablished by distance and direction. Show the discrepancy on the plan view drawing under (a), above. Show the distances between the corner as previously restored or reestablished and (1) the corner as restored or reestablished, and (2) to at least 4 of the witness monuments shown on the drawing in (a), above.
- (E) Was the corner reestablished through lost corner proportionate methods? If so, show the method, including the directions and distances to other public land survey corners used as evidence or used for proportioning the corner location.

I, Donald Barnes, hereby certify that the corner points as identified by the corner code index were, in a field survey on, JULY 31,1995, established, re-established, monumented, re-monumented, recovered or restored as expressed below and in conformance with the regulations and rules as required in the current manual of survey instructions of the United States Department of Interior, Bureau of Land Management.

| EMBOSS LAND SURVEYOR SEAL | A-E 7.08 | REQUIREMENT |
|---------------------------|----------|---------------------------------------|
| Donald Baines | | Number of included sheets CORNER CODE |
| | | Date microfilmed |
| seal | | Date of computer entry |
| | | COUNTY SURVEYOR FILING DATA |

8-30-95