Paper weight- 32# 25% Rag Ledger (minimum)


Black nonfading introduced

U.S.

## SURWE UBLIC RECORD MONUMENT

For Public Land Survey Corners in the T.3N., R. //\_E

CORNER CODE INDEX

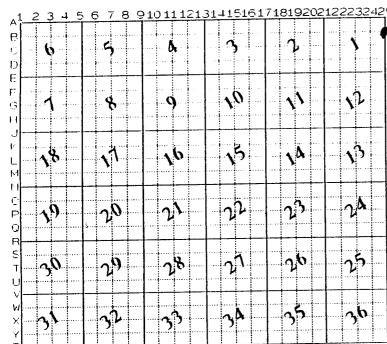

CEN	TER		W	i
ROCK	COUNTY	WI		

-	F AVAILABLE COORDINATES PERFERED
North	Elev.
East	
Hor. Datum	Vert. Datum
GPS (X)	TRAVERSE (X)
BASED ON THE FOLL	OWING CONTROL:

AL PROPER PLACE MONUMENT SYMBOL & LOCATION ON ABOVE INDEX

OCORNER MONUMENT

O WITHESS MONUMENT

BEARINGS ARE BASED ON:

(a)

FIELD BOOK PAGE #  SHOW A PLAN VIEW DRAWING DEPICTING THE CORNER MONDMENT AND SUPPROUNDING PHYSICAL FEA THE FOLLOWING CHARACTERISTICS: 1) HAVE A LEAST TWO PREDETERMINED BREAK-OFF FOILITS. 21 MUST BE EXTENDABLE. 4) THE CAP IS THISCRIBED TROCK COUNTY SURVEY MONAMENT - PENALT 24 MUST BE EXTENDABLE. 4) THE CAP IS THISCRIBED TROCK COUNTY SURVEY MONAMENT - PENALT 25 MUST BE EXTENDABLE. 4) THE CAP IS THOSE ROUND WATER IS WITHIN ONE FOOT OF THE SUFFACE DURABLE. DISTRICT MONAMENT MAY BE USED. CORNERS SHALL BE REFERENCED WITH AT LEAST 4 STOKELIBOT OR OTHER EQUÂLLY DURABLE MATERIAL E-CEPT MOOD DESCRIBE THE CORNER AND TO PLANHING S ZONITIO CONMITTEE ADOPTED THE ABOVE FORM ON 12/2/1982 WI ADMINISTRATIVE COOR A-E 7.08 PROUTER-EIT	TY FOR DISTURBING MARKER: 5) OR AN EXISTING OUT LINESTOIR. AN IRON PIPE 1 LY E. IF THE CORNER IS OCCUPIED BY AN IMPROVEMENT BIAN-POLEBURIED CABLESTO AND DURABLE WITHESS MOUNEMIS. WITHESS MONUMENTS SHALL BE MADE OF CONCRETE, MAILINA DURABLE WITHESS MOUNEMIS.
	CORNER CODE

- Describe any record evidence, monument evidence, occupational evidence, testimonial evidence or any other material evidence you considered, and whether the monument was found or placed. FOUND MONUMENT AS SHOWN IN DRAWING.
- Was the corner restored through acceptance of (1) an obliterated evidence location, or, (2) a found perpetuated location? THE MONUMENT WILL BE DISTURBED BY ROAD CONSTRUCTION. CORNER PERPETUATED AS FOUND.
- Describe any material discrepancy between the location of the corner as restored or reestablished and the location of that corner as previously restored or reestablished by distance and direction. Show the discrepancy on the plan view drawing under (a), above. Show the distances between the corner as previously restored or reestablished and (1) the corner as restored or reestablished, and (2) to at least 4 of the witness monuments shown on the drawing in (a), above.
- Was the corner reestablished through lost corner proportionate methods? If so, show the method, including the directions and distances to other public land survey corners used as evidence or used for proportioning the corner location. NO

I, Donald Barnes, hereby certify that the corner points as identified by the corner code index were, in a field survey on, JULY 31,1995, established, re-established, monumented, re-monumented, recovered or restored as expressed below and in conformance with the regulations and rules as required in the current manual of survey instructions of the United States Department of Interior, Bureau of Land Management.

COUNTY SURVEYOR FILING DATA

seal

EMBOSS LAND SURVEYOR SEAL

Date of computer entry Date microfilmed Number of included sheets CORNER CODE A-E 7.08 REQUIREMENT

B25

