
Paper weight- 32# 25% Rag Ledger (minimum)

Black nonfading ink reguled

SURVEY "UBLIC MONUMENT RECORD

For Public Land Survey Corners in the T. **3** N., R. ____E

CORNER CODE INDEX

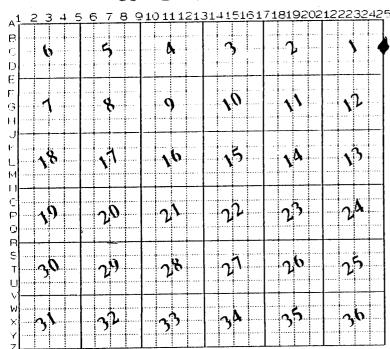

CENTER ROCK COUNTY WI

IF AVAILABLE ROCK COUNTY COORDINATES PERFERRED

North __ _____ Elev. East Hor. Datum _____ Vert. Datum _

TRAVERSE (X) ___ GPS (X) ____

BASED ON THE FOLLOWING CONTROL:

PLACE MONUMENT SYMBOL LOCATION ON ABOVE INCEX

OCORDER MONUMENT

O WITHESS MONUMENT

(a)

BEARINGS ARE BASED ON:

FIELD BOOK PAGE #


SHOW A PLAN VIEW DRAWLING DEPICTING THE COTHER MOLUMENT AND SUPPOLIDING PHYSICAL FEATURES, INCLUDING THE EXCAVATION AREA AND DEPTH. THE COPINER MOLUMENT SHALL HAVE THE FOLLOWING CHARGING: 1) HAVE A LEAST TWO PROBLEMENTS DREAK-OFF FOURTS. 2) IF BROKER LEAVE A PERMANENTLY MAGNETIZED REMAINT AT THE ORIGINAL POINT.

3) MUST BE EXTENDABLE. 4) THE CAP IS INSCRIBED TROCK COUNTY SURVEY MONAMENT - PENALTY FOR DISTURBING MARKER? 5) OR AN EXISTING CUT LIVESTORE. AN IRON PIPE I 1/2"Y

4' BININGHI MAY BE USED IT! ATREAS WHERE CROUND MARKER IS WITHIN DOME FOR THE SHEFACE. IF THE COPINER IS OCCUPIED BY AN INFROVEMENT BIANABLE REPORTED WITH AT LEAST 4 DURABLE WITHESS MONAMENTS. WITHESS MONAMENTS SHALL BE MADE OF CONCRETE, NATURAL STONE, IRON PIPE E MAY BE USED. CONTRETE. NATURAL STONE, IRON PIPE BY MAY BE USED. CONTRETE. NATURAL STONE, IRON PIPE BY MAY BE USED. CONTRETE. NATURAL STONE, IRON PIPE BY MAY BE USED. CONTRETE. NATURAL STONE, IRON PIPE BY MAY BE USED. CONTRETE. NATURAL STONE, IRON PIPE BY MAY BE USED. CONTRETE. NATURAL STONE, IRON PIPE BY MAY BE USED. CONTRETE. NATURAL STONE, IRON PIPE BY MAY BE USED. CONTRETE. NATURAL STONE, IRON PIPE BY MAY BY M

PLAINING & ZONTING CONMITTEE ADOPTED THE ABOVE FORM ON 12/2/1992 WI ADMINISTRATIVE CODE A-E 7.08 REQUIRENED!

SHEET / OF 2

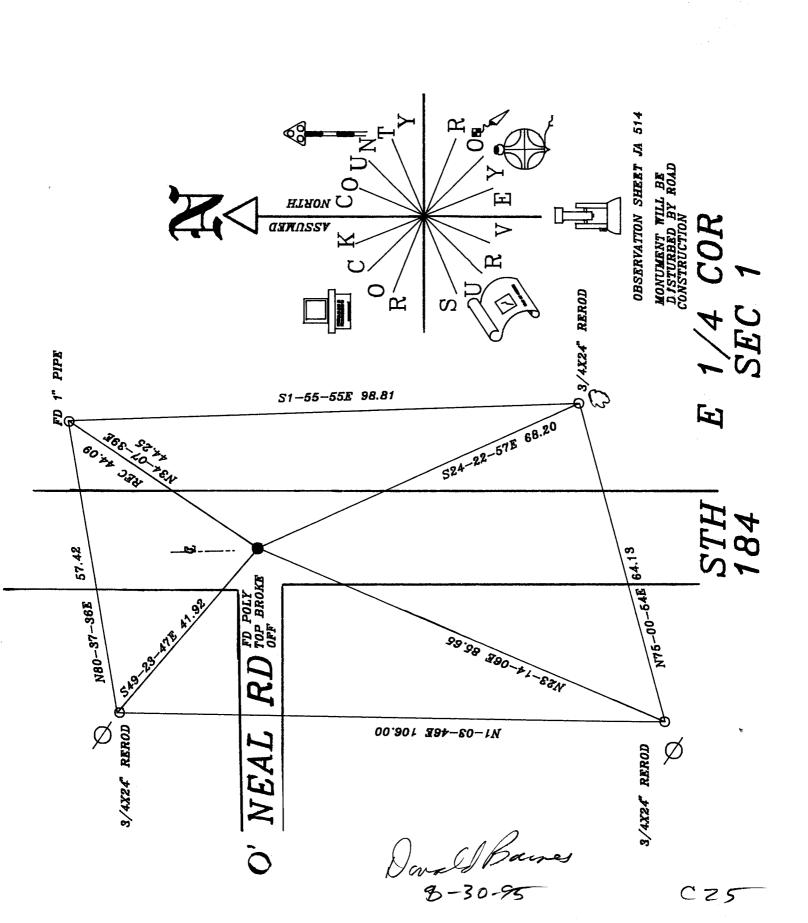

- (B) Describe any record evidence, monument evidence, occupational evidence, testimonial evidence or any other material evidence you considered, and whether the monument was found or placed.
 FOUND MONUMENT AS SHOWN IN DRAWING.
- C) Was the corner restored through acceptance of (1) an obliterated evidence location, or, (2) a found perpetuated location?
 THE MONUMENT WILL BE DISTURBED BY ROAD CONSTRUCTION. CORNER PERPETUATED AS FOUND.
- D) Describe any material discrepancy between the location of the corner as restored or reestablished and the location of that corner as previously restored or reestablished by distance and direction. Show the discrepancy on the plan view drawing under (a), above. Show the distances between the corner as previously restored or reestablished and (1) the corner as restored or reestablished, and (2) to at least 4 of the witness monuments shown on the drawing in (a), above.
- (E) Was the corner reestablished through lost corner proportionate methods? If so, show the method, including the directions and distances to other public land survey corners used as evidence or used for proportioning the corner location.

I, Donald Barnes, hereby certify that the corner points as identified by the corner code index were, in a field survey on, JULY 31,1995, established, re-established, monumented, re-monumented, recovered or restored as expressed below and in conformance with the regulations and rules as required in the current manual of survey instructions of the United States Department of Interior, Bureau of Land Management.

A-E 7.08 REQUIREMENT

COUNTY SURVEYOR FILING DATA
Date of computer entry
Date microfilmed
Number of included sheets

EMBOSS LAND SURVEYOR SEAL

seal

8-30-95