


U.S. PUBLIC LAND SURVEY MONUMENT RECORD

For Public Land Survey Corners in the
 T. 3 N., R. 12 E.
CORNER CODE INDEX

	1	2	3	4	5	6	7	8	9	10	11	12	13	14	15	16	17	18	19	20	21	22	23	24	25
A																									
B																									
C	6																								
D		5																							
E			4																						
F				3																					
G					2																				
H																									
I	7																								
J		8																							
K			9																						
L				10																					
M					11																				
N						12																			
O	16																								
P		17																							
Q			18																						
R				19																					
S					20																				
T						21																			
U							22																		
V								23																	
W									24																
X										25															
Y	30																								
Z		29																							
			28																						
				27																					
					26																				
EXAMPLE

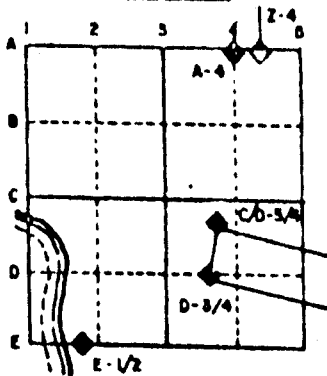

JANESVILLE TWP
ROCK COUNTY WI

IF AVAILABLE
 STATE PLANE COORDINATES

North (Y) 267,521.58 Eleve. (Z) _____

East (X) 3244,016.30 Zone _____

Hor. Datum _____ Vert. Datum _____

HURD 267,520.94


2,244,015.48

PLACE MONUMENT SYMBOL (◆) AT PROPER
 LOCATION ON ABOVE INDEX

◆ CORNER MONUMENT

○ WITNESS MONUMENT

BEARINGS ARE BASED ON: ASSUMED

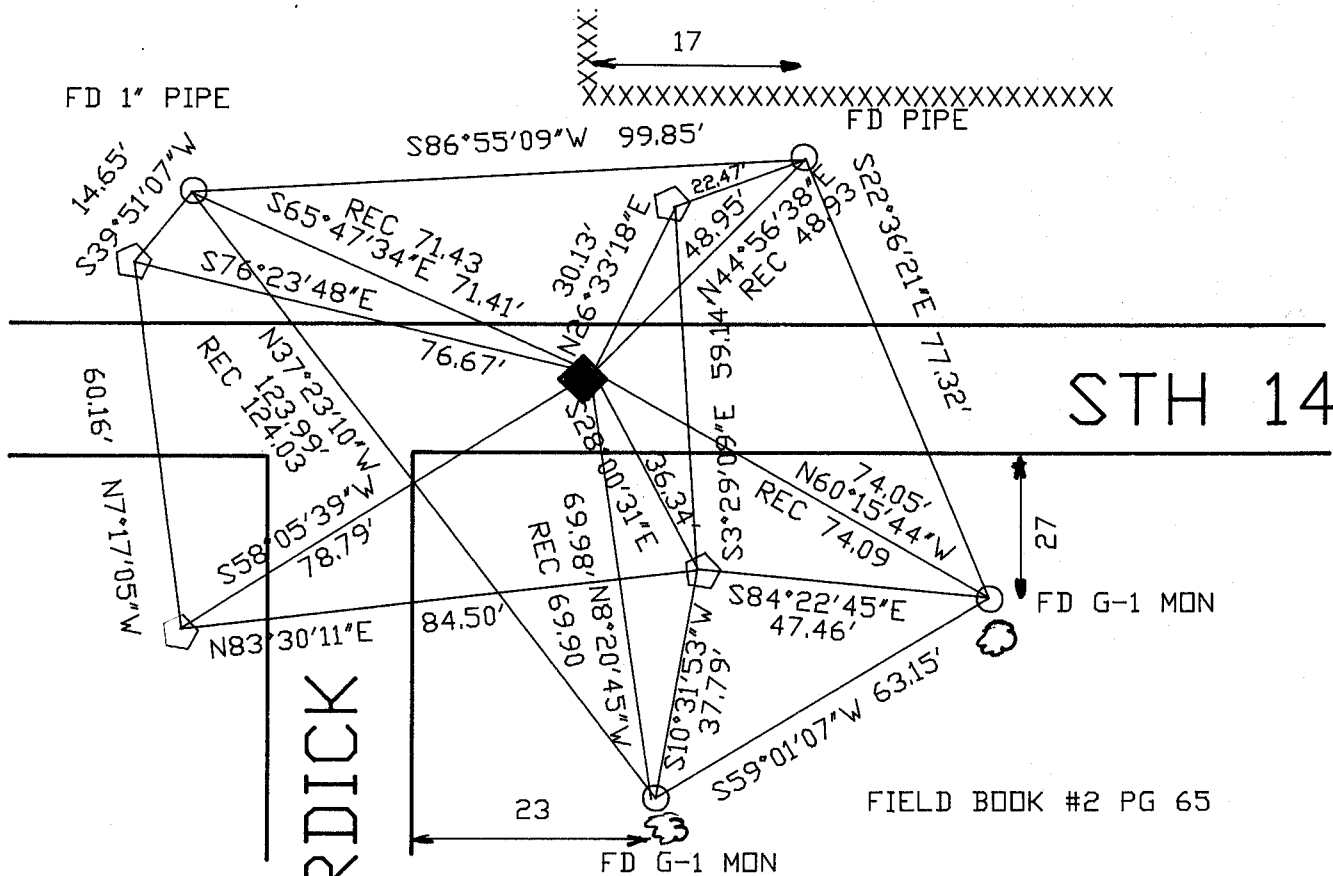

DOT REPORTED THAT TOP OF
 MONUMENT WAS MILLED OFF PRIOR TO REFERENCING

- ◇ FOUND DOT ALUM DISK
- ◆ FOUND POLY MONUMENT WITH TOP MILLED OFF
 MONUMENT IS 4.7 NORTH OF THE CENTER
 OF THE PAVEMENT & 33 FROM THE CENTER OF
 THE PAVEMENT OF BURDICK RD.

MICROFILMED

SHEET 1 OF 1

CORNER CODE: 59(1)

(B) Describe any record evidence, monument evidence, occupational evidence, testimonial evidence or any other material evidence you considered, and whether the monument was found or placed.

1986 BARNES J9 FOUND PK AT ROAD SURFACE. 2' DEEP FOUND PIPE. DROVE PIPE DEEP AND PLACED POLY MONUMENT ON TOP.

DOT PROJECT ENGINEER STATED THAT THE ROAD CONSTRUCTION CONTRACTOR MILLED THE SURFACE PRIOR TO DOT'S CREW REFERENCING THE CORNER. FOUND POLY MONUMENT WITH TOP MILLED OFF. REFERENCED SAME.


C) Was the corner restored through acceptance of (1) an obliterated evidence location, or, (2) a found perpetuated location?

ACCEPTED FOUND PERPETUATED MONUMENT.

D) Describe any material discrepancy between the location of the corner as restored or reestablished and the location of that corner as previously restored or reestablished by distance and direction. Show the discrepancy on the plan view drawing under (a), above. Show the distances between the corner as previously restored or reestablished and (1) the corner as restored or reestablished, and (2) to at least 4 of the witness monuments shown on the drawing in (a), above.

(E) Was the corner reestablished through lost corner proportionate methods? If so, show the method, including the directions and distances to other public land survey corners used as evidence or used for proportioning the corner location.

I, Donald Barnes, hereby certify that the corner points as identified by the corner code index were, in a field survey on, JULY 15, 1991, established, re-established, monumented, re-monumented, recovered or restored as expressed below and in conformance with the regulations and rules as required in the current manual of survey instructions of the United States Department of Interior, Bureau of Land Management.

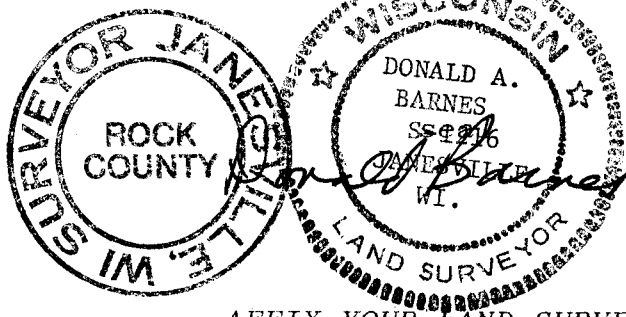

AFFIX YOUR LAND SURVEYOR SEAL

COUNTY SURVEYOR FILING DATA

Date of computer entry _____

Date microfilmed _____

Number of included sheets _____
CORNER CODE