

# U.S. PUBLIC LAND SURVEY MONUMENT RECORD

For Public Land Survey Corners in:

WI ADMINISTRATIVE CODE A-E 7.08 REQUIREMENT

T. 3 N., R. 12 E

CORNER CODE INDEX

JANESVILLE TWP  
ROCK COUNTY WI

IF AVAILABLE  
ROCK COUNTY COORDINATES PREFERRED

A	2	3	4	5	6	7	8	9	10	11	12	13	14	15	16	17	18	19	20	21	22	23	24	25	
B																									
C	6									A			3								2			1	
D																									
E																									
F																									
G	1									8			9								10			11	12
H																									
I																									
J																									
K																									
L	18									11			16								15			14	13
M																									
N																									
O																									
P	19									20			21								22			23	24
Q																									
R																									
S																									
T	30									29			28								27			26	25
U																									
V																									
W																									
X	31									32			33								34			35	36
Y																									
Z																									


North 81,593.439m Elev. \_\_\_\_\_  
East 679,194.501m  
Hor. Datum NAD83 Vert. Datum \_\_\_\_\_

LATITUDE \_\_\_\_\_ ELLIPS. HT. \_\_\_\_\_

LONGITUDE \_\_\_\_\_

GPS (X) \_\_\_\_\_ TRAVERSE (X) \_\_\_\_\_

BASED ON THE FOLLOWING CONTROL:

PLACE MONUMENT SYMBOL  AT PROPER LOCATION ON ABOVE INDEX

 CORNER MONUMENT

 WITNESS MONUMENT

(a) DISK


NOTE ON PLAT: COORDINATES & BEARINGS ON THIS PLAT ARE ORIENTED TO THE WI COORDINATE SYSTEM SOUTH ZONE, NAD 83. ALL PLAT DISTANCES ARE GROUND LENGTH AND MAY BE CONVERTED TO GRID LENGTH BY MULTIPLYING THE DISTANCE BY THE GRID FACTOR PROVIDED ON THE DETAIL SHEETS.

WIDOT PROJ. #5569-03-21 DATE: MAY 19 1995

BEARINGS ARE BASED ON:

COUNTY  
286,418.17 FT  
490,546.06

267,694.48 FT  
2,228,323.96  
NAD83

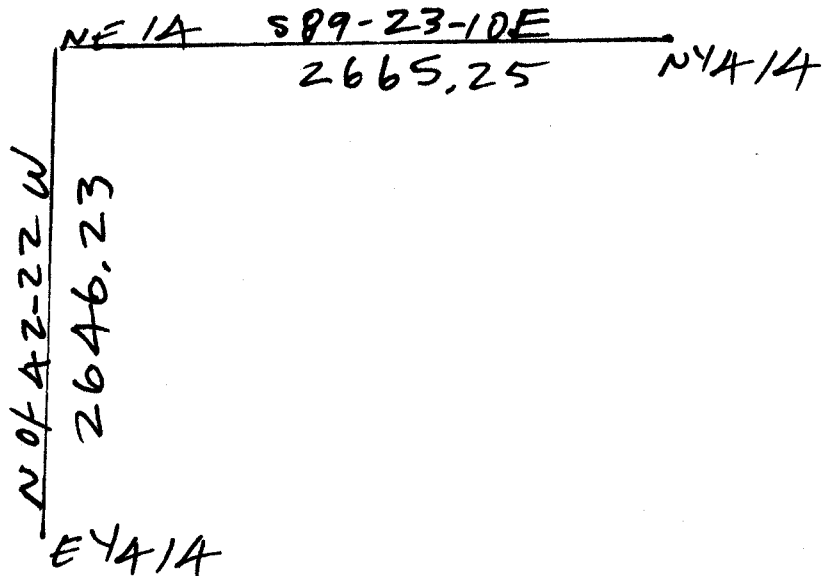

Dr Barnes

FIELD BOOK \_\_\_\_\_ PAGE # 4-02-04

SHEET 1 OF 1

SHOW A PLAN VIEW DRAWING DEPICTING THE CORNER MONUMENT AND SURROUNDING PHYSICAL FEATURES, INCLUDING THE EXCAVATION AREA AND DEPTH.

PLANNING & ZONING COMMITTEE ADOPTED THE ABOVE FORM ON 12/2/1982

CORNER CODE J-21(4)