


PLAT AND RECORD

Of a Survey on Section 31 T 3 N R 11 E of the 4 P. M. in CENTER Township
Rock County, Wisconsin, made JUNE the 24th 1974

I hereby certify that the following is a correct record of said survey as made by me.

COUNTY BUILDING
IN CITY OF БЕЛОИТ

Hugh J. See
County Surveyor.

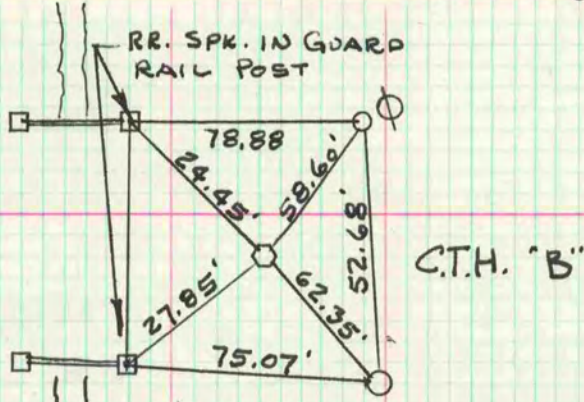

6-24-74
SET ALUM. MON.
N. 1/4 COR. BK 170/101
ML RL