


PLAT AND RECORD

Of a Survey on Section 1 T 2 R 12 E. of the 4 P. M. in Rock Township
 Sept. 26 - 1870 + Jan. 6 + 7 - 1874 + Nov. 16 - 1874 +
 Rock County, Wisconsin, made April the 27 1877

I hereby certify that the following is a correct record of said survey as made by me.

COUNTY BUILDING
 IN CITY OF БЕЛОIT

(Signed) Edward Ruger - Dept. Co. Surveyor +
 R.H.B. County Surveyor.

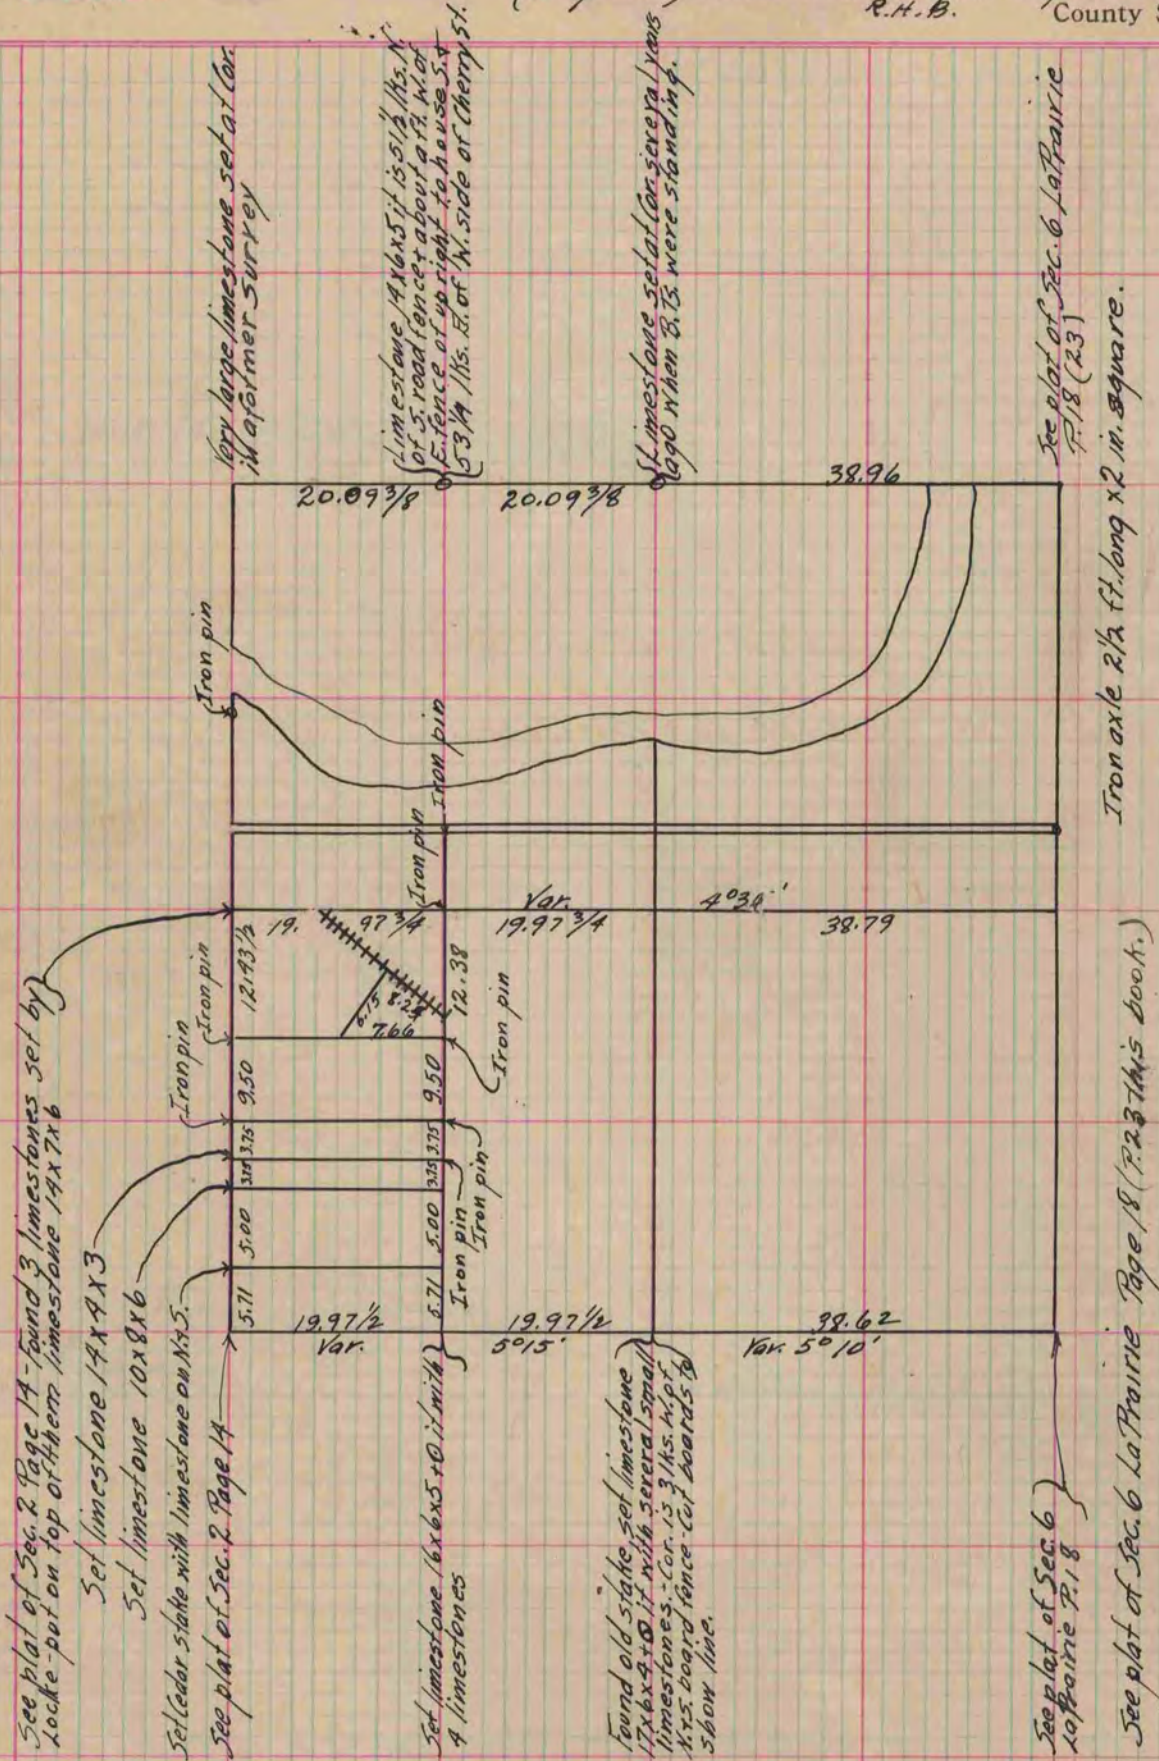

Copied from Page 27 Vol. 2. Original County Surveyor's Record.