

# PLAT AND RECORD

Of a Survey on Section 23 T 2 R 11 E. of the 4 P. M. in Plymouth Township


Rock County, Wisconsin, made Nov. 30 + Dec. the 16, 17 + 19 1870

I hereby certify that the following is a correct record of said survey as made by me.

COUNTY BUILDING  
IN CITY OF BELoit

(Signed) Edward Reger  
CMB

Deputy  
County Surveyor.

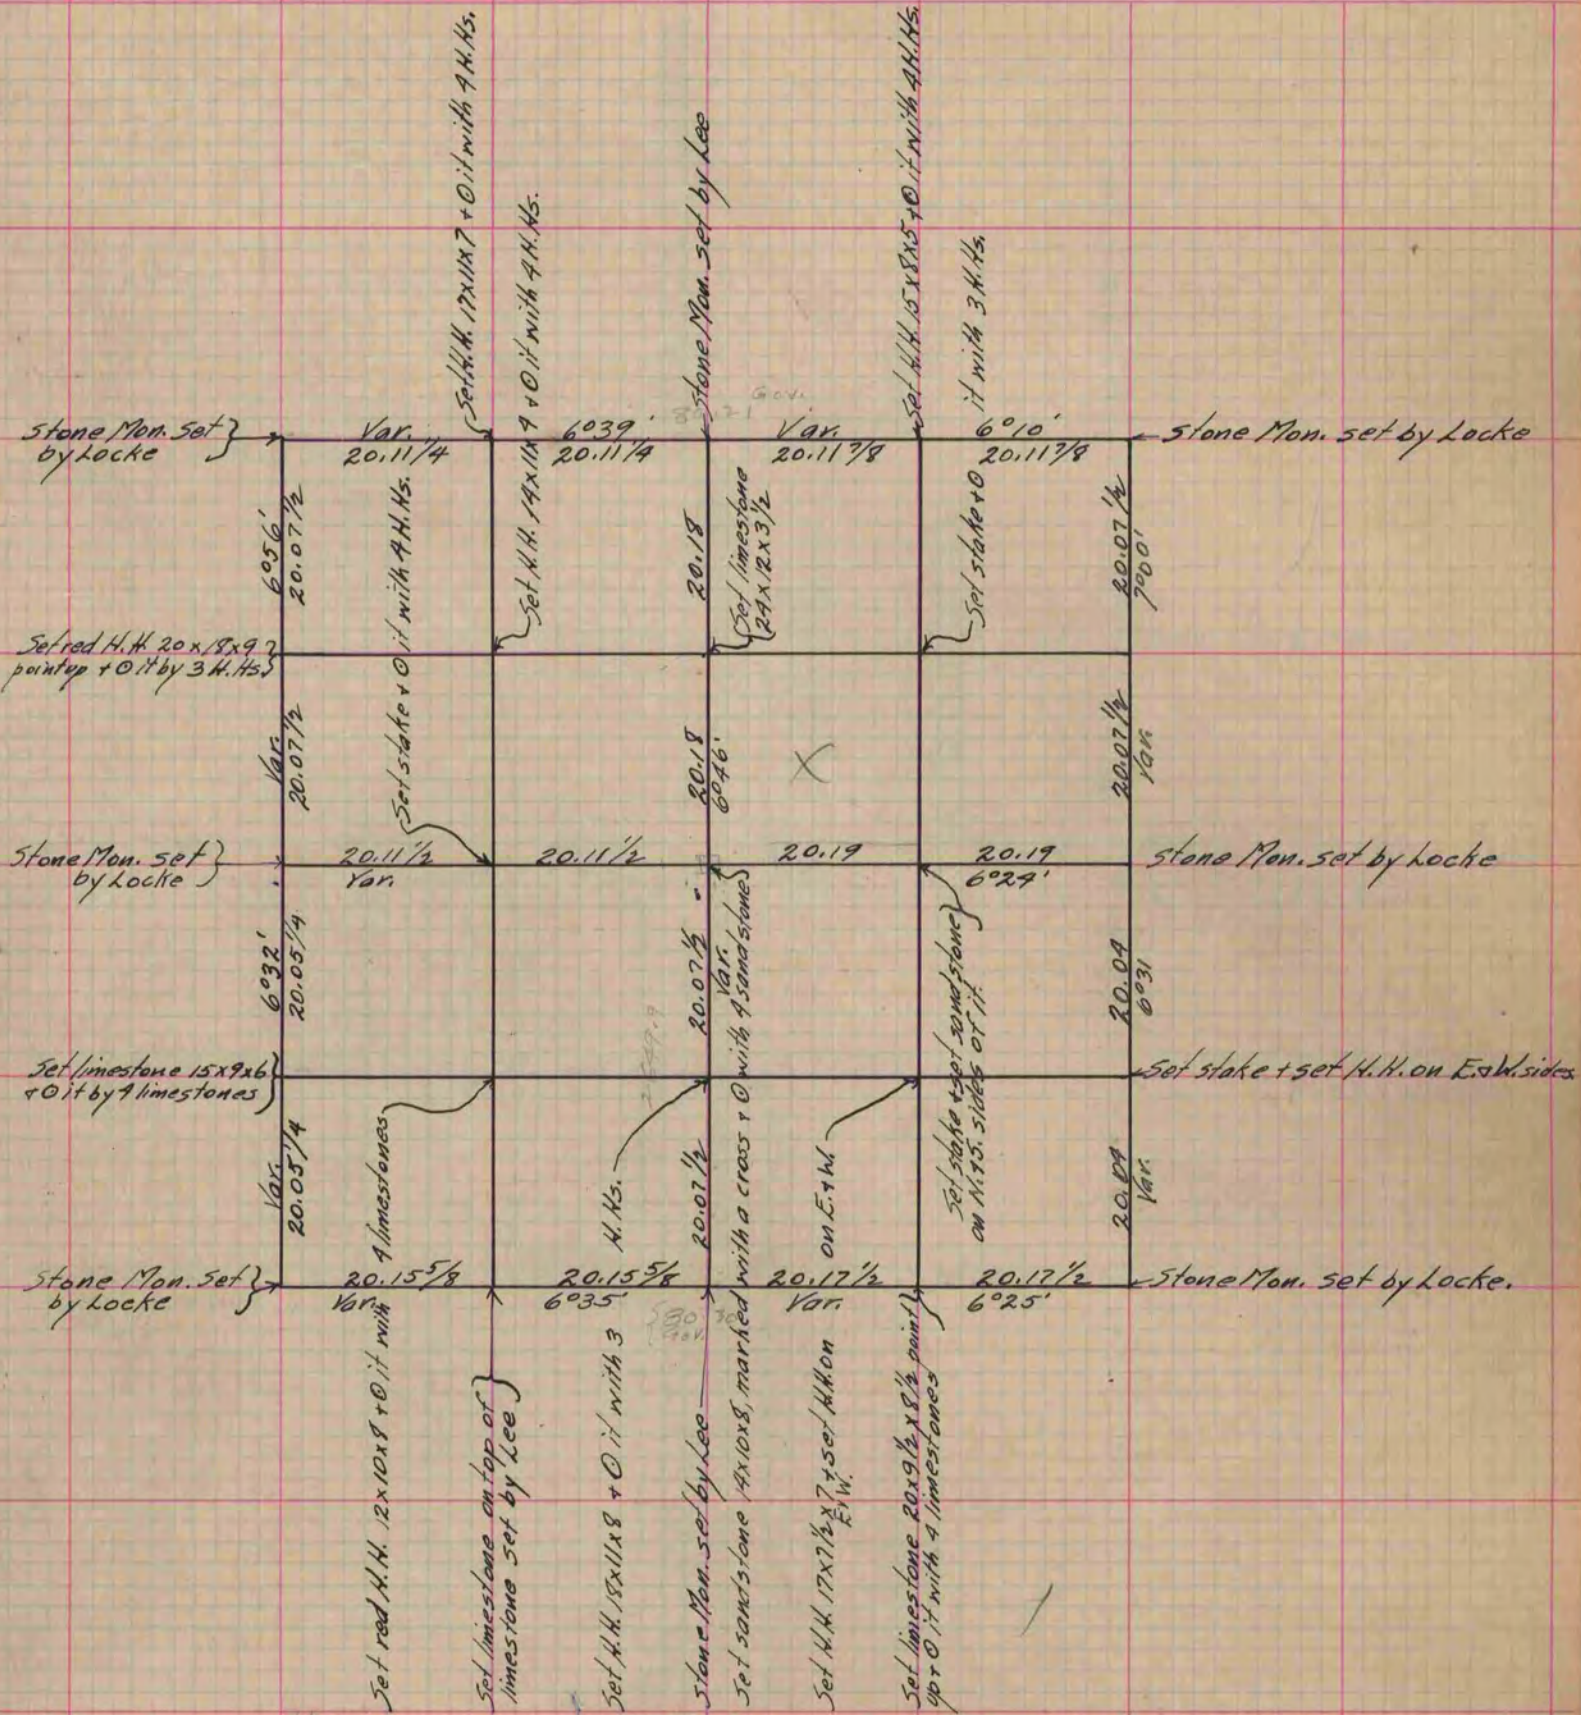

Copied from Page 31 Vol. 2 Original County Surveyors Record.