

PLAT AND RECORD


Of a Survey on Section 33 T 2 R 11 E. of the 4 P. M. in Plymouth Township
 Rock County, Wisconsin, made October the 9-10-11 1871

I hereby certify that the following is a correct record of said survey as made by me.

COUNTY BUILDING
IN CITY OF BELLOIT

(Signed) Edward Ruger
E. R.

County Surveyor.

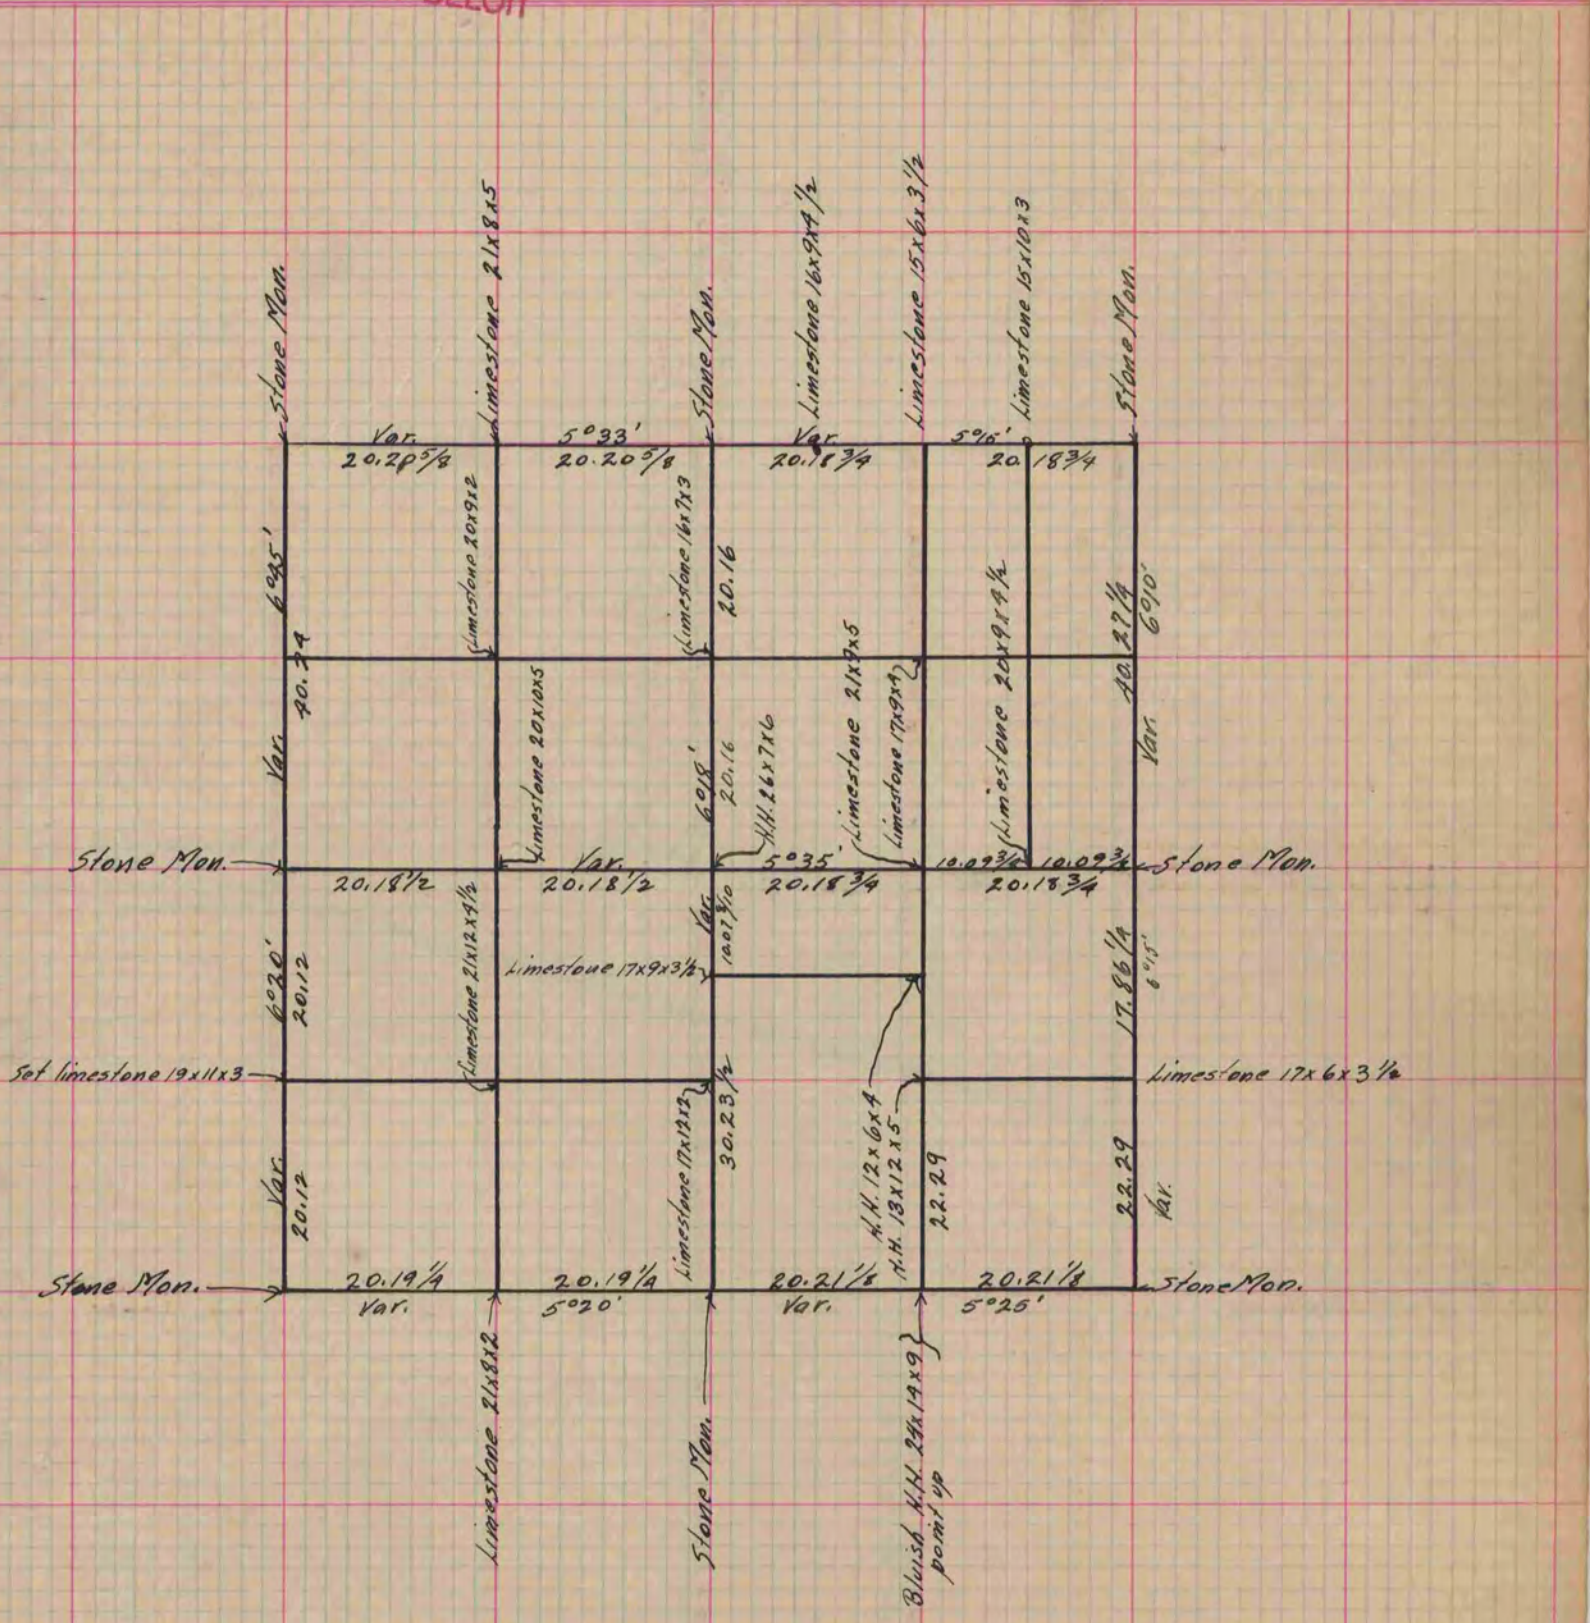

Copied from Page 45 Vol. 2 Original County Surveyor's Record.