
aper weight- 32# 25% Rag Ledger (minimum)

Black nontading introduced

SURVE UBLIC MONUMENT RECORD

For Public Land Survey Corners in the T. L.N., R. 13E

CORNER CODE INDEX

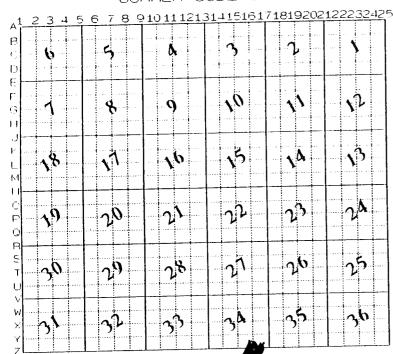

TURTLE ROCK COUNTY WI

IF AVAILABLE BOOK COUNTY COORDITIATES PERFERRED

North 200,726,55 Elev. East 5/5,563,62

Hor. Datum COUNTY Vert. Datum _____

TRAVERSE (X) X GPS (X) ____

BASED ON THE FOLLOWING CONTROL:

AT PROPER PLACE MONUMENT SYMBOL & LOCATION ON ABOVE INCEX

CORNER MONUMENT

O WITHESS MONUMENT

(a)

BEARINGS ARE BASED ON:

Fd CONCROTE MON

SHEET ___OF Z___

PLAINING & ZONING COMMITTEE ADOPTED THE ABOVE FORM ON 12/2/1982 WT ADMINISTRATIVE CODE A-E 7.08 REQUIRENEIS

CORNER CODE 2 16/17

NW 6 R3E 4007 ILL501R3

- (B) Describe any record evidence, monument evidence, occupational evidence, testimonial evidence or any other material evidence you considered, and whether the monument was found or placed.
- 1838 ILLINOIS ORIGINAL GOVERNMENT PLAT. CORNER SHOWN TO BE 1758.9' WEST OF THE SE CORNER OF SEC 34. CALLS FOR A VAR OF 5-5'.
- 192? TISSANDIER MAP 5318.35 TO NW COR SEC 1 T46N R2E. ANGLE OF 179-55-44 AT NW COR SEC 1 FROM NE COR SEC 1 TO NW COR SEC 2. LAT 42-30'15.12"; LONG 88-57-48.73". NORTH FENCE OF ROAD.

FOUND BRASS PIN IN CONCRETE MONUMENT IN E/W FENCE LINE ON NORTH SIDE OF ROAD. PLACED CARSONITE POST. 1788.07 (REC 1758.9) WEST OF THE SE COR SEC 34, 5312.73 (REC 5318.35) TO NW COR SEC 1, & AN ANGLE OF 179-57-42 (REC 179-55-44) AT THE NW COR SEC 1 FROM THE NE COR SEC 1 TO THE NW COR SEC 2.

- C) Was the corner restored through acceptance of (1) an obliterated evidence location, or, (2) a found perpetuated location?
 ACCEPTED FOUND PERPETUATED LOCATION.
- D) Describe any material discrepancy between the location of the corner as restored or reestablished and the location of that corner as previously restored or reestablished by distance and direction. Show the discrepancy on the plan view drawing under (a), above. Show the distances between the corner as previously restored or reestablished and (1) the corner as restored or reestablished, and (2) to at least 4 of the witness monuments shown on the drawing in (a), above.
- (E) Was the corner reestablished through lost corner proportionate methods? If so, show the method, including the directions and distances to other public land survey corners used as evidence or used for proportioning the corner location.

I, Donald Barnes, hereby certify that the corner points as identified by the corner code index were, in a field survey on,1994, established, re-established, monumented, re-monumented, recovered or restored as expressed below and in conformance with the regulations and rules as required in the current manual of survey instructions of the United States Department of Interior, Bureau of Land Management.

	COUNTY SURVEYOR FILING DATA
seal	Date of computer entry
	Date microfilmed
7/12/95	Number of included sheets CORNER CODE

EMBOSS LAND SURVEYOR SEAL

216/17

ILLINOIS ORIGINAL GOVERNMENT FIELD NOTES T46N R2&3E CERTIFICATE DEC 29,1836

D.A. SPAULDING WILLIAM TOP

DT.

JAMES THOMAS

CH CHAINMAN

R. WALLER

CHAINMAN

A special design is contact that is a second of the second

FLAGMAN

HENRY CHANDLER

AXE MAN

ALL CORNER POSTS WERE INSERTED 2' INTO A HOLE DUG IN THE GROUND WITH AN AXE & SPADE THROUGH THE FROST & THEY WERE SECURELY RAMMED IN WITH EARTH. THE STONES USED FOR CORNERS WERE OBTAINED AT DIFFERENT QUARRIES IN THE ?? AND WERE SET 1 1/2 THEIR LENGTH IN THE GROUND & ON ALL THE N/S LINES, THEY WERE SET THE WEST SIDE OF THE POSTS & EDGES FACING N/S AND ON THE E/W LINES THEY WERE SET THE NORTH SIDE OF THE POSTS & EDGES FACING E & W.

THE SAID POSTS WERE OF THE MOST DURABLE WOOD THAT COULD BE HAD IN THE LAND GENERALLY BURR OAK. THE SECTION POSTS WERE 5' LONG & WERE NOT LESS THAN 5" IN DIA., THAT THEY WERE NEATLY SQUARED AT TOP & THEN PLACED WITH THE CORNERS TO THE CARDINAL POINTS. (CONTINUES WITH OTHER STATEMENTS).

PAGE 857. DEC 26, 1838 MEASURED CHAIN COMPARED WITH THE STANDARD CHAIN & LIST IT TO BE A HALF INCH TOO LONG. MAKE IT OF THE PROPER LENGTH.