ILL4019

(B) Describe any record evidence, monument evidence, occupational evidence, testimonial evidence or any other material evidence you considered, and whether the monument was found or placed.

1836 SPAULDING ORIG SURVEY. INTERSECTED THE BASE LINE OF THE NORTH WEST TERRITORY AND NORTH BOUNDARY OF ILLINOIS 431.64' EAST OF THE QUARTER SECTION CORNER ON THE SOUTH BOUNDARY OF SECTION 32 TOWNSHIP ONE NORTH RANGE 12 EAST OF THE 4TH PRINCIPLE MERIDIAN AND AT SAID INTERSECTION SET A POST AND STONE FOR CORNER TO SECTIONS 2 & 3 T46N R1E OF THE 3RD PM. SAID STONE IS 14" LONG 12" WIDE & 5" THICK. SET ONE IN 8 INCHES IN THE GROUND WEST SIDE OF POST. CALLS FOR 1838.1' TO W 1/4 COR SEC 2. AT W 1/4 COR SEC 2 SET A POST AND STONE . SAID STONE IS 14" LONG 12" WIDE AND 4" SET ONE IN 7 INCHES IN THE GROUND EDGES FACING NORTH AND THICK. SOUTH.

192? TISSANDIER SET CONCRETE MONUMENT WITH BRASS PLUG. LAT 42 30' 22.36" LONG 89 07' 19.78". 5220.00 TO NW COR SEC 3,5252.60 TO NE COR SEC 2, AND ANGLE 179-55-57 (CLOCKWISE) FROM NE COR SEC 2 TO NW COR SEC 3. IP 15.00 TO THE NORTH AND IP 48.00 TO THE SW.

1976 LEE CSM VOL 6 PG 306 3074.52 TO SW COR SEC 32

1983 BARNES VOL 6 PG 306 431.64 TO S 1/4 COR SEC 32 & 5254.08 TO NE COR SEC 2,2218.17 TO SE COR SEC 32

FOUND CONCRETE MONUMENT WITH BRASS PLUG ON WEST SIDE OF HOUSE DRIVEWAY ON NORTH SIDE OF ROAD. THE FOLLOWING WERE MEASURED: 5254.21 (5254.08,5252.60 REC) TO NE COR SEC 2, 5218.14 (5220.00 REC), 179-55-39 (179-53-57 REC) CLOCKWISE FROM NE COR SEC 2 TO NW COR SEC 3, & 2218.22 (2218.17 REC) TO SE COR SEC 32.

- C) Was the corner restored through acceptance of (1) an obliterated evidence location, or, (2) a found perpetuated location? DID NOT ACCEPT NOR REJECT FOUND LOCATION.
- D) Describe any material discrepancy between the location of the corner as restored or reestablished and the location of that corner as previously restored or reestablished by distance and direction. the discrepancy on the plan view drawing under (a), above. distances between the corner as previously restored or reestablished and (1) the corner as restored or reestablished, and (2) to at least 4 of the witness monuments shown on the drawing in (a), above.
- (E) Was the corner reestablished through lost corner proportionate methods? If so, show the method, including the directions and distances to other public land survey corners used as evidence or used for proportioning the corner location. NO
- I, Donald Barnes, hereby certify that the corner points as identified by the corner code index were, in a field survey on, established, reestablished, monumented, re-monumented, recovered or restored as expressed below and in conformance with the regulations and rules as required in the current manual of survey instructions of the United States Department of Interior, Bureau of Land Management.

on seaffaires OUT 20, 1998

COUNTY SURVEYOR FILING DATA

Date of computer entry_

Date microfilmed ___

Number of included sheets CORNER CODE

EMBOSS LAND SURVEYOR SEAL


A-E 7.08 REQUIREMENT

U.S.

PUBLIC LAND SURVEY MONUMENT RECORD

For Public Land Survey Corners in: T. N., R. E

CORNER CODE INDEX

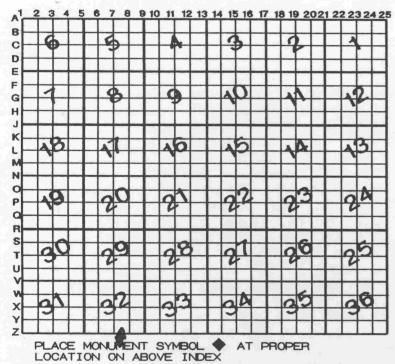

WI ADMINISTRATIVE CODE A-E 7.08 REQUIREMENT

BELOIT TWP

ROCK COUNTY WI

IF AVAILABLE ROCK COUNTY COORDINATES PERFERRED

North 201, 238, 60 Elev. ____

Hor. Datum COUNTY Vert. Datum

LATITUDE _____ELLIPS. HT.

LONGITUTE

GPS (X) __ TRAVERSE (X) __

BASED ON THE FOLLOWING CONTROL:

♦ CORNER MONUMENT

O WITNESS MONUMENT

BEARINGS ARE BASED ON:

(a)

		1 1
FIELD BOOKPAGE #	SHEET	_ OF
SHOW A PLAN VIEW DRAWING DEPICTING THE CORNER MONUMENT AND	SURROUNDI	NG
PHYSICAL FEATURES, INCLUDING THE EXCAVATION AREA AND DEPTH.		
PLANNING & ZONING COMMITTEE ADOPTED THE ABOVE FORM ON 12/2/1982		
		7/0

ORNER CODE 2 7/8