U.S.

(a)

BASED ON: COUNTY SYSTEM


BEARINGS ARE

PUBLIC LAND SURVEY MONUMENT RECORD

For Public Land Survey Corners in:

T. / N., R. /2 E

CORNER CODE INDEX

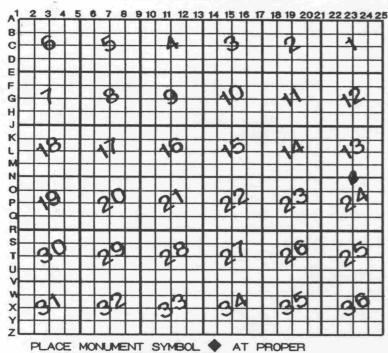

WI ADMINISTRATIVE CODE A-E 7.08 REQUIREMENT

ROCK COUNTY WI

IF AVAILABLE
ROCK COUNTY COORDINATES PERFERRED

North 2/6, 879, 32 Elev.

East 493, 67/.20

Hor. Datum County Vert. Datum

LATITUDE _____ELLIPS. HT.

LONGITUTE

GPS (X) ___

TRAVERSE (X)

BASED ON THE FOLLOWING CONTROL:

♦CORNER MONUMENT

O WITNESS MONUMENT

N 1/4 COR SEC 13 FD HARD HEAD S89-30-47E WITH DRILL 5.71 NW COR HOLE FD 1" PIPE SEC 24 NE COR N89-34-18W SEC 24 S89-34-10E 2646.03 2645.97 N 1/4 COR SEC 24 3/4X24 REROD

OBSERVATION SHEET #326

FIELD BOOK _____PAGE # ____ SHEET ____ OF SHOW A PLAN VIEW DRAWING DEPICTING THE CORNER MONUMENT AND SURROUNDING PHYSICAL FEATURES, INCLUDING THE EXCAVATION AREA AND DEPTH.
PLANNING & ZONING COMMITTEE ADOPTED THE ABOVE FORM ON 12/2/1982

CORNER CODE N-23

BE572

(B) Describe any record evidence, monument evidence, occupational evidence, testimonial evidence or any other material evidence you considered, and whether the monument was found or placed.

1878 RUGER VOL 2 PG 239 FOUND L.S. AT COR. JUST EAST OF FENCE POST IN N/S FENCE & IN LINE WITH FENCE RUNNING E&W.

1953 BATTERMAN MAP #3518 FOUND LIMESTONE.

1953 BATTERMAN MAP 3507 FOUND STONE

1955 BATTERMAN MAP #329 FOUND MONUMENT BUT STATED NOTHING ABOUT IT 2645
TO CENTER SEC 24.

1955 BATTERMAN MAP #3507 FOUND MONUMENT BUT STATED NOTHING ABOUT IT. 2645.34 TO CENTER SEC 24.

1956 BATTERMAN SUBDIVISION PLAT BK 17 PG 32 CONNECTED TO CORNER.

1956 BATTERMAN SUBDIVISION PLAT BK 18 PG 10 FOUND CUT LIMESTONE.

1957 BATTERMAN MAP #3513 FOUND LIMESTONE.

1958 BATTERMAN SUBDIVISION PLAT BK 19 PG 14 FOUND STONE

1958 BATTERMAN SUBDIVISION PLAT BK 19 PG 27 FOUND CUT STONE.

1963 BATTERMAN SUBDIVISION PLAT BK 22 PG 6 FOUND STONE.

1976 LEE MAP #4251 FOUND MONUMENT BUT STATES NOTHING ABOUT IT. 90-12-20 FROM NE TO CENTER OF SEC 24

FOUND HARD HEAD WITH DRILL HOLE. IN HARMONY WITH BATTERMAN'S ANGLE TO CENTER OF SEC 24 AND DISTANCE TO NE COR SEC 24.

- C) Was the corner restored through acceptance of (1) an obliterated evidence location, or, (2) a found perpetuated location? ACCEPTED FOUND PERPETUATED LOCATION.
- D) Describe any material discrepancy between the location of the corner as restored or reestablished and the location of that corner as previously restored or reestablished by distance and direction. Show the discrepancy on the plan view drawing under (a), above. Show the distances between the corner as previously restored or reestablished and (1) the corner as restored or reestablished, and (2) to at least 4 of the witness monuments shown on the drawing in (a), above.
- (E) Was the corner reestablished through lost corner proportionate methods? If so, show the method, including the directions and distances to other public land survey corners used as evidence or used for proportioning the corner location.

I, Donald Barnes, hereby certify that the corner points as identified by the corner code index were, in a field survey on, MAY, 1997, established, re-established, monumented, re-monumented, recovered or restored as expressed below and in conformance with the regulations and rules as required in the current manual of survey instructions of the United States Department of Interior, Bureau of Land Management.

seal

Date of computer entry

Date microfilmed

Number of included sheets

EMBOSS LAND SURVEYOR SEAL

A-E 7.08 REQUIREMENT

N-23

CORNER CODE