

PUBLIC LAND SURVEY MONUMENT RECORD


For Public Land Survey Corners in the

T. 1 N., R. 13 E.

CORNER CODE INDEX

	1	2	3	4	5	6
A						
B	6	5	4	3	2	
C						
D						
E						
F						
G	7	8	9	10	11	12
H						
I						
J						
K						
L	16	17	18	19	20	21
M						
N						
O						
P						
Q	26	20	21	22	23	24
R						
S						
T	30	29	28	27	28	25
U						
V						
W						
X	31	32	33	34	35	36
Y						

EXAMPLE

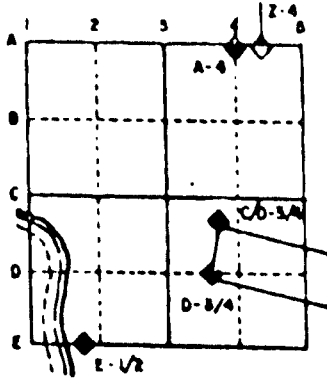

TURTLE TWP
ROCK COUNTY WI

IF AVAILABLE
STATE PLANE COORDINATES

North (Y) 221,975.83 Elev. (Z) _____

East (X) 514,685.27 Zone _____

Hor. Datum COUNTY Vert. Datum _____

PLACE MONUMENT SYMBOL (◆) AT PROPER LOCATION ON ABOVE INDEX

◆ CORNER MONUMENT

○ WITNESS MONUMENT

◆d BRASS DISK
IN CONCRETE MON.

FD TIES IN J15

BEARINGS ARE BASED ON:

SHEET ___ OF ___

515(1)

CORNER CODE:

(B) Describe any record evidence, monument evidence, occupational evidence, testimonial evidence or any other material evidence you considered, and whether the monument was found or placed.

- 1864 LOCKE VOL 1 PG 204 FOUND OLD STAKE. BTs GONE. SET BR OAK STAKE DEEP & ABOVE IT SANDSTONE 25X15X11.5 & SURROUNDED IT BY HALF A DOZEN HHs IN MOUND. 2654.52 TO SE COR SEC 10 & 2643.30 TO CENTER SEC 10.
- 1867 LEE VOL 1 PG 333 FOUND CORNER SET BY LOCKE. 2651.88 TO NW COR SEC 15.
- 1868 LEE VOL 1 PG 334 FOUND STAKE SET BY LOCKE 2657.82 TO CENTER OF SEC 10.
- 1880 LEE VOL 2 PG 304 FOUND CORNER SET BY LOCKE. 2647.92 TO NW COR SEC 15.
- 1966 LEE VOL 1 PG 204 FOUND ON DR. HEGGY SURVEY.
- 1986 BARNES VOL 6 PG 364 FOUND DISK IN CONCRETE. 2654.97 TO SW COR SEC 10.
- 1986 BARNES J15 FOUND BRASS DISK IN CONCRETE. REFERENCED MONUMENT. PLACED CARSONITE ON EAST SIDE OF MONUMENT.

FOUND BRASS DISK IN CONCRETE & REFERENCE MONUMENTS.

C) Was the corner restored through acceptance of (1) an obliterated evidence location, or, (2) a found perpetuated location?
ACCEPTED FOUND PERPETUATED LOCATION.

D) Describe any material discrepancy between the location of the corner as restored or reestablished and the location of that corner as previously restored or reestablished by distance and direction. Show the discrepancy on the plan view drawing under (a), above. Show the distances between the corner as previously restored or reestablished and (1) the corner as restored or reestablished, and (2) to at least 4 of the witness monuments shown on the drawing in (a), above.

(E) Was the corner reestablished through lost corner proportionate methods? If so, show the method, including the directions and distances to other public land survey corners used as evidence or used for proportioning the corner location.

NO

I, Donald Barnes, hereby certify that the corner points as identified by the corner code index were, in a field survey on, 1994, established, re-established, monumented, re-monumented, recovered or restored as expressed below and in conformance with the regulations and rules as required in the current manual of survey instructions of the United States Department of Interior, Bureau of Land Management.

seal

Donald Barnes
7/12/95

EMBOSS LAND SURVEYOR SEAL

COUNTY SURVEYOR FILING DATA

Date of computer entry _____

Date microfilmed _____

Number of included sheets _____
CORNER CODE _____

A-E 7.08 REQUIREMENT

515(1)