
PUBLIC LAND SURVEY MONUMENT RECORD

For Public Land Survey Corners in:

WI ADMINISTRATIVE CODE A-E 7.08 REQUIREMENT

T. 3N., R. 12E

CORNER CODE INDEX

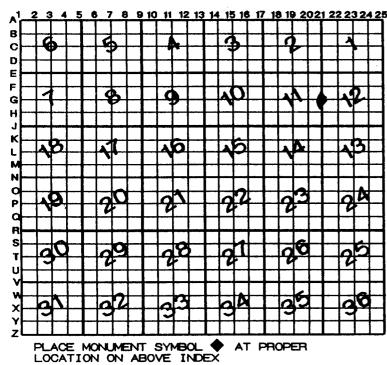

TANESVILE TWI

IF AVAILABLE ROCK COUNTY COORDINATES PERFERRED

North	Elev
East	
Hor. Datum	Vert. Datum
LATITUDE	ELLIPS. H
LONGITUTE	
GPS (X)	TRAVERSE (X)
BASED ON THE	FOLLOWING CONTROL:

♦CORNER MONUMENT

O WITNESS MONUMENT

BEARINGS ARE BASED ON:

(a)

OBSERVATION	SHEET
-------------	-------

FIELD BOOK _____PAGE # _

SHEET \angle OF \angle

SHOW A PLAN VIEW DRAWING DEPICTING THE CORNER MONUMENT AND SURROUNDING PHYSICAL FEATURES, INCLUDING THE EXCAVATION AREA AND DEPTH.

PLANNING & ZONING COMMITTEE ADOPTED THE ABOVE FORM ON 12/2/1982

JA539

- (B)Describe any record evidence, monument evidence, occupational evidence, testimonial evidence or any other material evidence you considered, and whether the monument was found or placed.
- 1873 RUGER VOL 2 PG 19 CORNER LOST ESTABLISHED ON A TRUE LINE BETWEEN & EQUAL DISTANCE FROM SECTION CORNERS. SET WHITE HARD HEAD 11X7X4.
- 1890 BLEEDHORN VOL 2 PG 438 STONE SET BY RUGER DUG OUT. SET HH 14X10X9
- 1939 SUNNY DUG 6X6X4 DEEP AND FOUND NOTHING.
- 1961 BATTERMAN JR. VOL 4 PG 221 NOTES 1" PIPE WHICH IS NOT REFERENCED.
- 1977 BARNES VOL 5 PG 343 FOUND 1 1/4" PIPE HORIZONTAL POSITION THAT WAS WITH IN A FOOT OF LINE BETWEEN THE SW & NW CORNERS.
- 1987 BARNES G-21 PLACED POLY MONUMENT ON LINE & EQUAL DISTANCE FROM SW AND NW CORNERS OF SEC 12.

FOUND POLY. MONUMENT AND REFERENCE MONUMENTS.

C) Was the corner restored through acceptance of (1) an obliterated evidence location, or, (2) a found perpetuated location?

ACCEPTED FOUND PERPETUATED LOCATION.

- D) Describe any material discrepancy between the location of the corner as restored or reestablished and the location of that corner as previously restored or reestablished by distance and direction. Show the discrepancy on the plan view drawing under (a), above. Show the distances between the corner as previously restored or reestablished and (1) the corner as restored or reestablished, and (2) to at least 4 of the witness monuments shown on the drawing in (a), above.
- (E) Was the corner reestablished through lost corner proportionate methods? If so, show the method, including the directions and distances to other public land survey corners used as evidence or used for proportioning the corner location.

I, Donald Barnes, hereby certify that the corner location as identified by the corner code index was determined by me under my direction and control and that this U.S. Public Land Survey Monument Record is correct and complete to the best of my knowledge and belief.

May 6, 1999

Number of included sheets 1

emboss

