

PLAT AND RECORD


Of a Survey on Section 5 T 3 R 10 E. of the 4 P. M. in Magnolia Township
Rock County, Wisconsin, made June the 23rd 1863

I hereby certify that the following is a correct record of said survey as made by me.

(Signed) S. D. Locke.
RHB

County Surveyor.

COUNTY BUILDING
IN CITY OF BELOIT

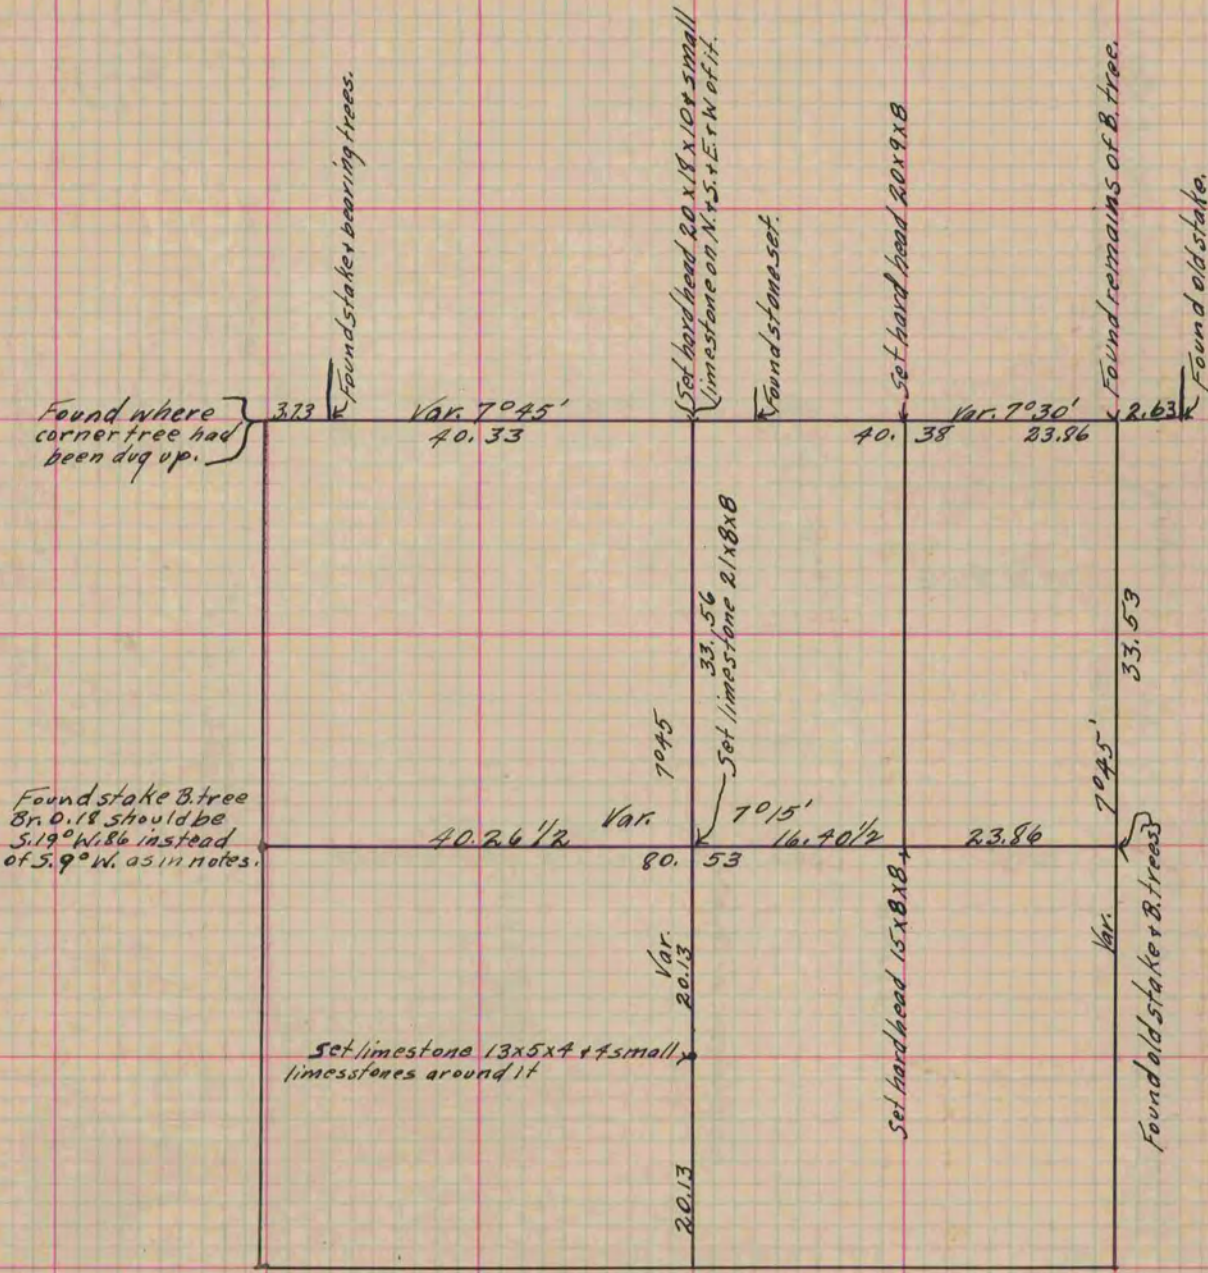

Copied from lower part of Page 191 Vol. 1. Original County Surveyor's Record.