

PLAT AND RECORD


Of a Survey on Section 24 T 3 R 14 E. of the 4 P. M. in Johnstown Township

Rock County, Wisconsin, made February the 11, 12+13 1863

I hereby certify that the following is a correct record of said survey as made by me.

COUNTY BUILDING
IN CITY OF BELOIT

(Signed) Sylvanus D. Locke
R.D.S. County Surveyor.

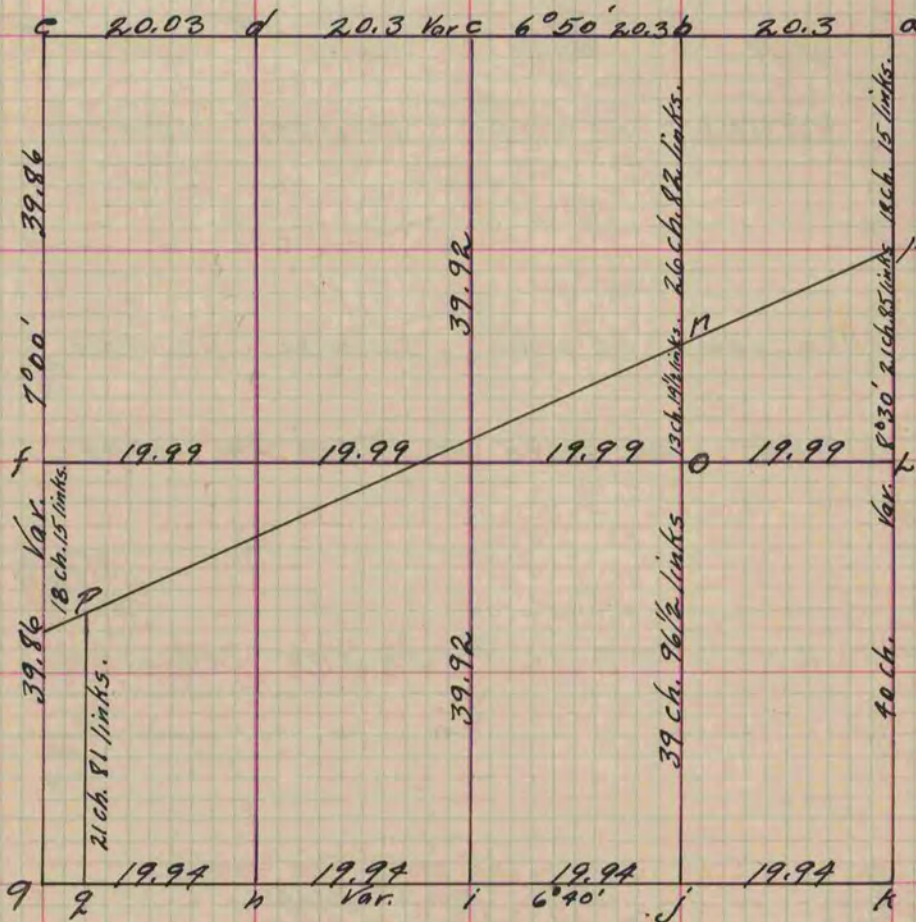

- At "a" found corner established by Tubbs Wal. Co. Surveyor. Stone in center of highway.
- " "b" Set stake + 2 stones below surface surrounding stake.
- " "c" " " "3" " " " Found stump of Southern witness tree.
- " "d" " " " " " " " " " " " " " " " "
- " "e" " " " " " " " " " " " " " " " "
- " "f" " " " " " " " " " " " " " " " "
- " "g" " " " " " " " " " " " " " " " "
- " "h" " " " " " " " " " " " " " " " "
- " "i" " " " " " " " " " " " " " " " "
- " "j" " " " " " " " " " " " " " " " "
- " "k" " " " " " " " " " " " " " " " "
- " "l" " " " " " " " " " " " " " " " "
- " "m" " " " " " " " " " " " " " " " "
- " "n" " " " " " " " " " " " " " " " "
- " "o" " " " " " " " " " " " " " " " "
- " "p" " " " " " " " " " " " " " " " "
- " "q" " " " " " " " " " " " " " " " "
- " "r" " " " " " " " " " " " " " " " "
- " "s" " " " " " " " " " " " " " " " "
- " "t" " " " " " " " " " " " " " " " "
- " "u" " " " " " " " " " " " " " " " "
- " "v" " " " " " " " " " " " " " " " "
- " "w" " " " " " " " " " " " " " " " "
- " "x" " " " " " " " " " " " " " " " "
- " "y" " " " " " " " " " " " " " " " "
- " "z" " " " " " " " " " " " " " " " "

Copied from Page 184 Vol. 1 Original County Surveyors Record