

PLAT AND RECORD


Of a Survey on Section 29 T 3 R 10 E. of the 4 P. M. in Magnolia Township
Rock County, Wisconsin, made April the 13th 1861

I hereby certify that the following is a correct record of said survey as made by me.

COUNTY BUILDING
IN CITY OF BELOIT

(Signed) Edward Ruger
ERTB

County Surveyor.

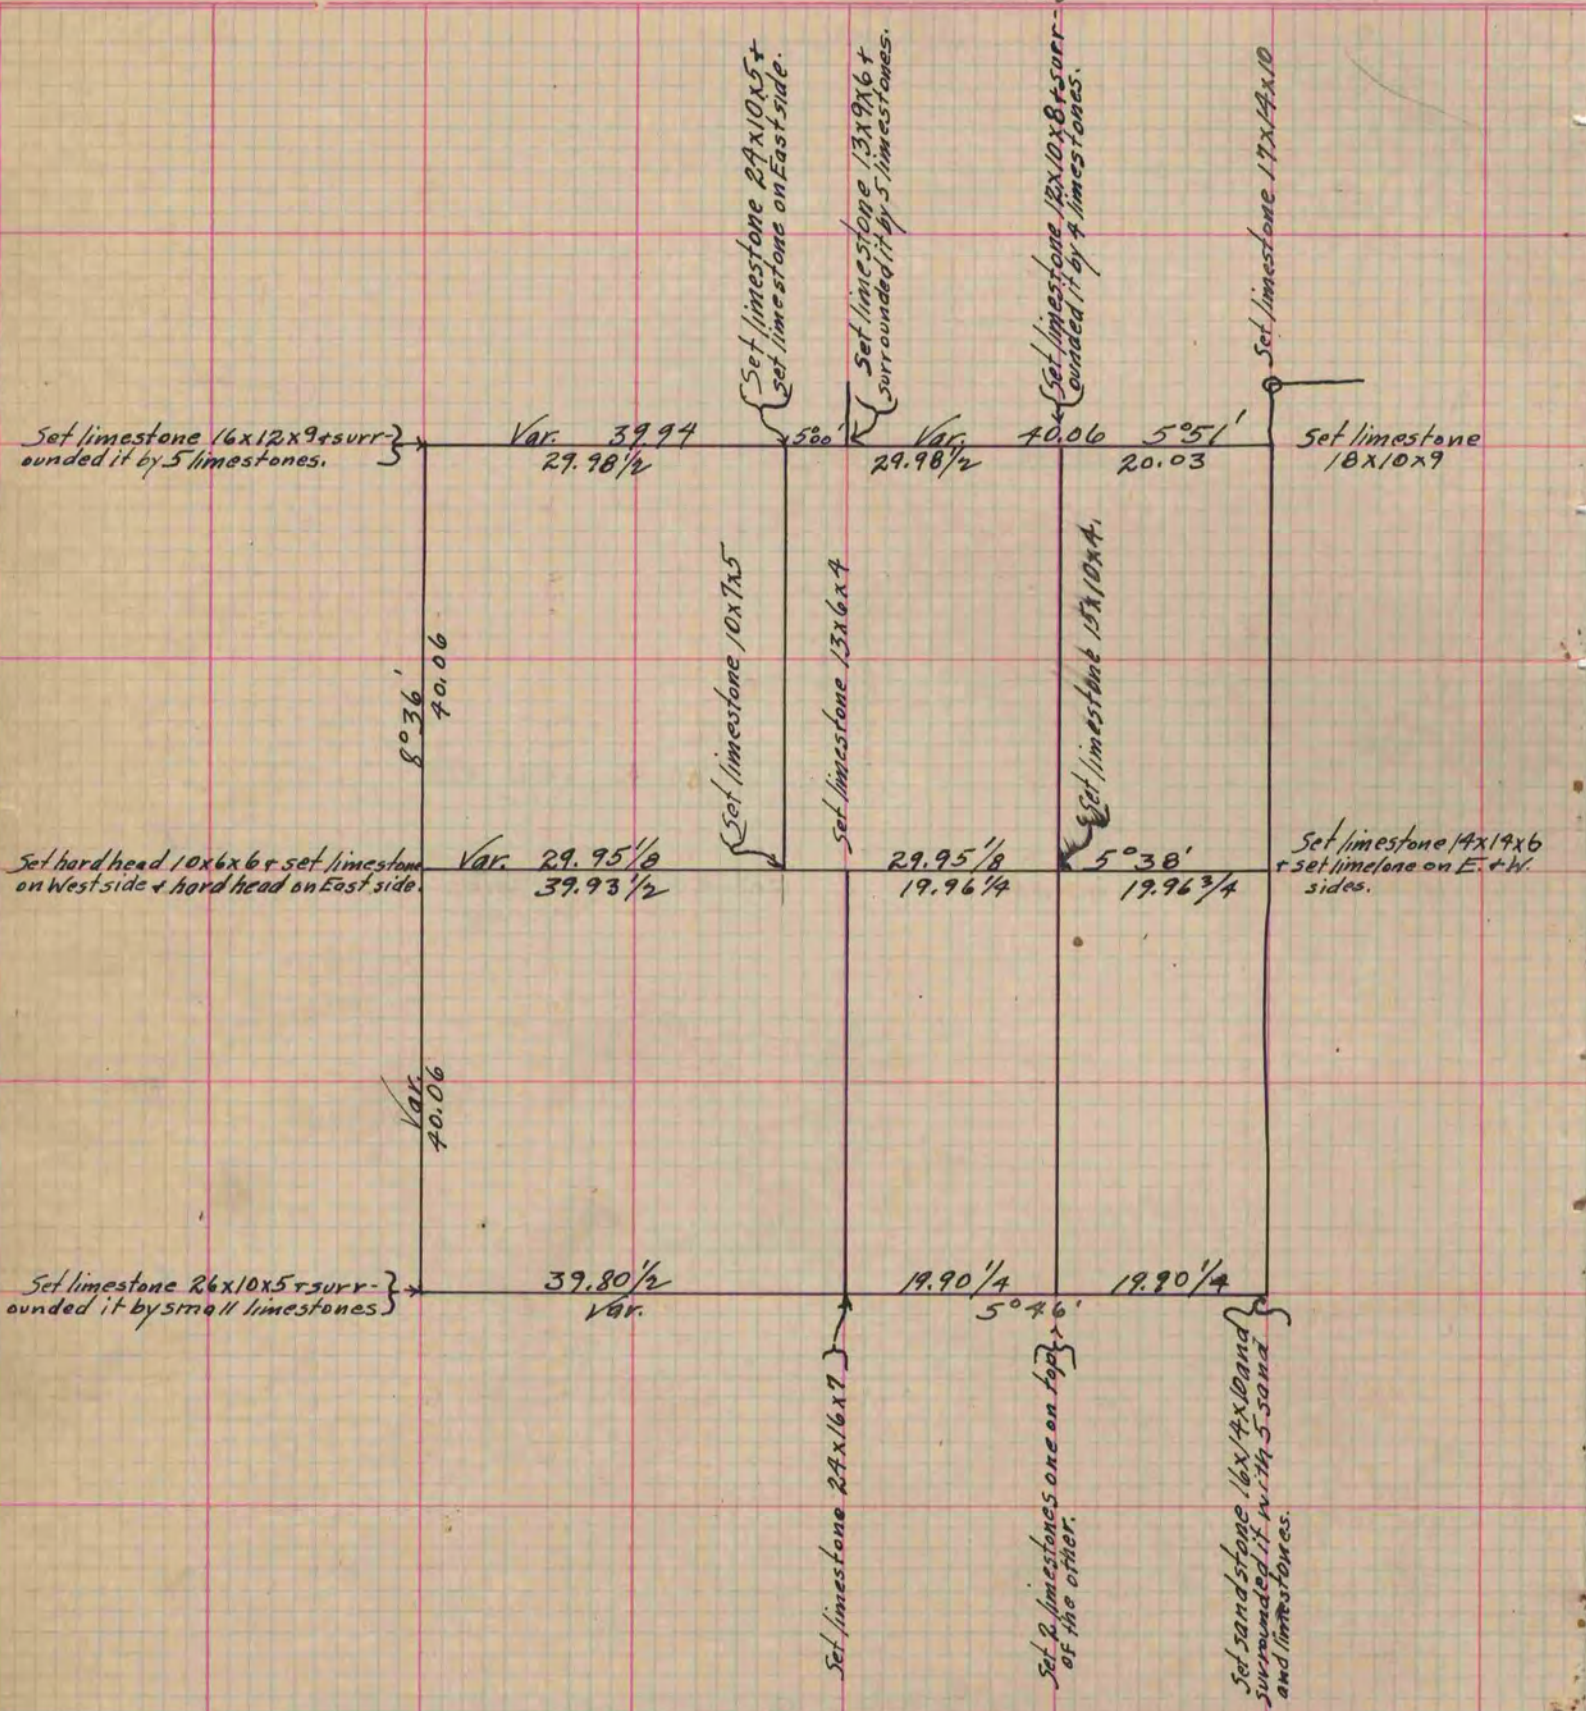

Copied from Page 167 Vol. 1. Original County Surveyors Record.