


Of a Survey on Section 24 T. 1 R. 11 E. of the 4 P. M. in Newark Township
Rock County, Wisconsin, made July the 1st 1863

I hereby certify that the following is a correct record of said survey as made by me.

COUNTY BUILDING
IN CITY OF БЕЛОIT

(Signed) S. D. Locke
RMB

County Surveyor.

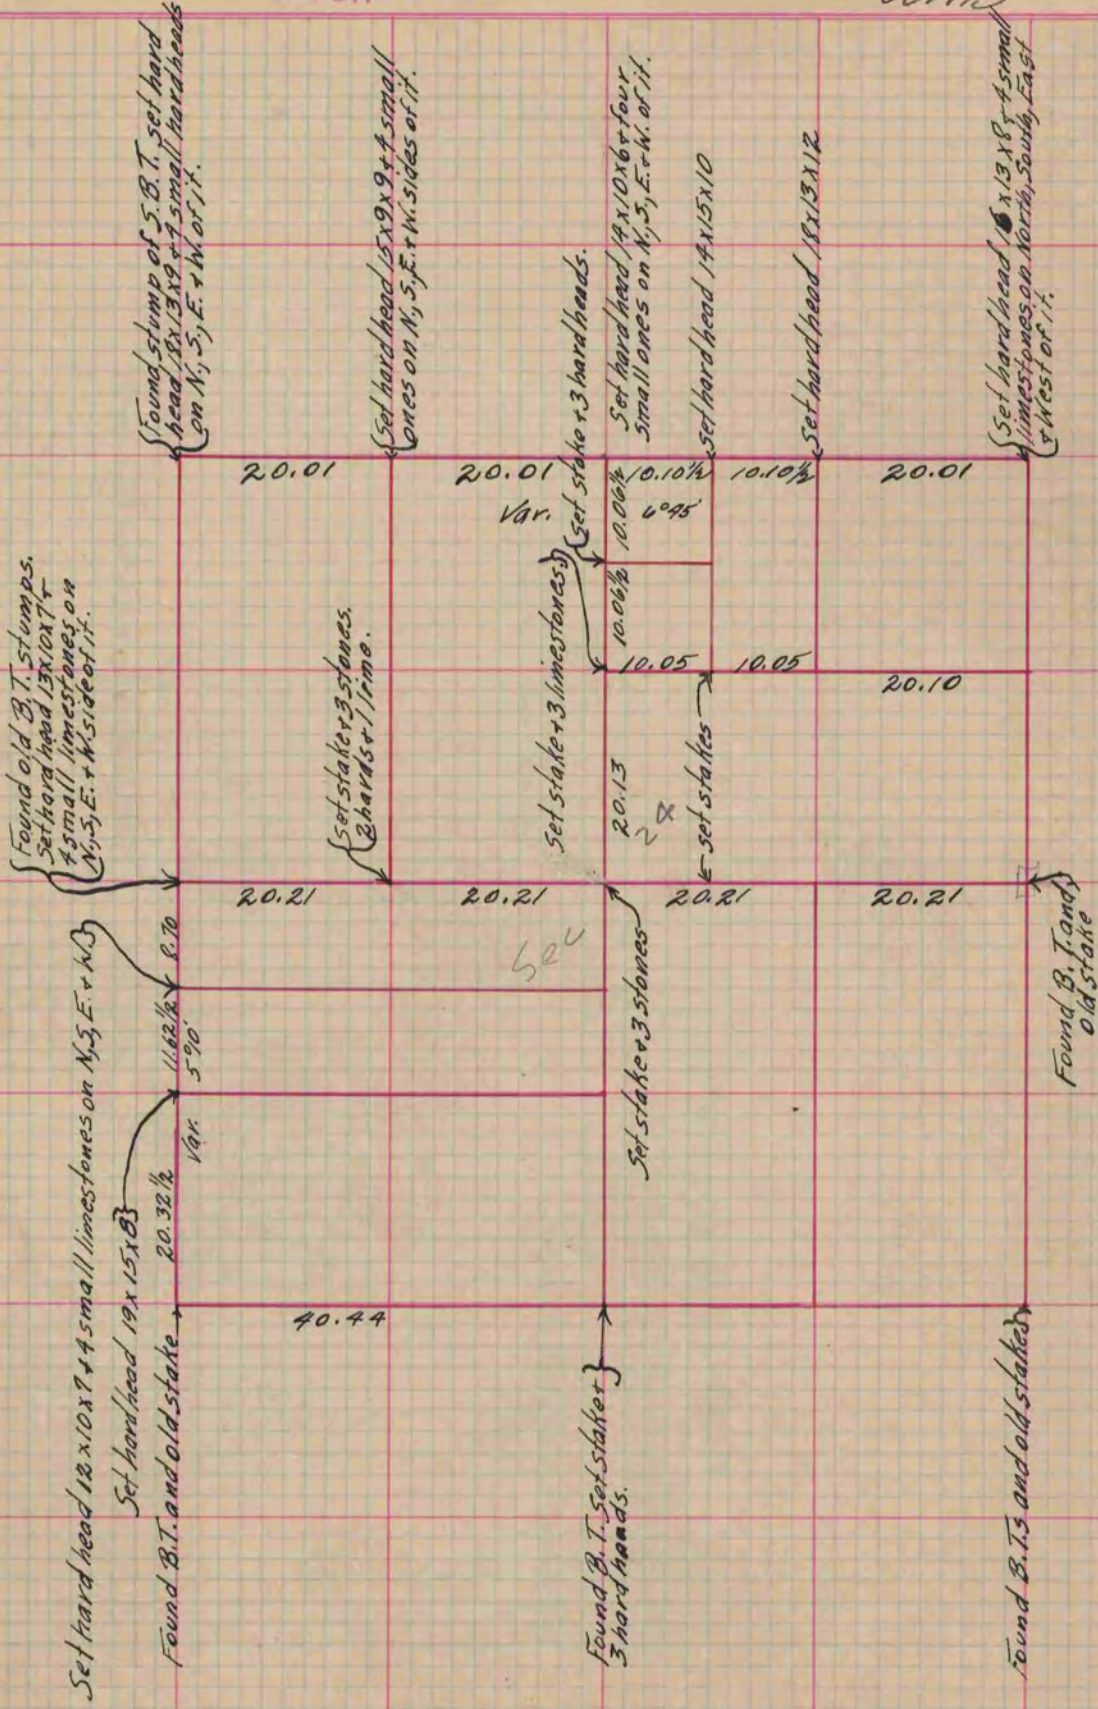

Copied from Lower part of Page 192 Vol. 1 Original (Surveyor's Record.)