



(B) Describe any record evidence, monument evidence, occupational evidence, testimonial evidence or any other material evidence you considered, and whether the monument was found or placed.

1869 LEE VOL 1 PG 351 PLACED 26X12X4 LIMESTONE. CALLS FOR 1544.40 TO W 1/4 CORNER, 1326.60 TO W 1/16TH CORNER OF NW 1/4, AND 1315.05 TO W 1/16TH CORNER OF SW 1/4 OF SECTION 30.  
1877 RUGER VOL 2 PG 267 CORNER SET BY LEE 6.6 TOO FAR EAST. SET IT CORRECTLY. LIMESTONE 26X12X4. CALLS FOR 1326.60 TO CENTER AND 1544.40 TO W 1/4 CORNER OF SECTION 30.

FOUND LIMESTONE 26X8X4. PLACED MAGNET ON NORTH SIDE AND CARSONITE POST ON EAST SIDE. PLACED A 3/4X24 REROD WITH PLASTIC CAP N7-13-29W 25.14. WEST QUARTER CORNER IS N87-53-50W 1546.18. LIMESTONE IS 6.17 SOUTH OF A LINE BETWEEN THE EAST AND WEST QUARTER CORNERS OF SECTION 30. COMPUTED 1331.60 TO THE COMPUTED CENTER OF THE NW 1/4 OF SECTION 30.


C) Was the corner restored through acceptance of (1) an obliterated evidence location, or, (2) a found perpetuated location?

DID NOT ACCEPT NOR REJECT FOUND MONUMENT. MONUMENT NEEDS TO BE VERIFIED BY LOCATING AND MEASURING TO THE MONUMENTS THAT LEE PLACED TO THE NORTH AND SOUTH. IT APPEARS THAT RUGER MAY HAVE INCORRECTLY MOVED THE STONE SOUTH THE 6.6'.

D) Describe any material discrepancy between the location of the corner as restored or reestablished and the location of that corner as previously restored or reestablished by distance and direction. Show the discrepancy on the plan view drawing under (a), above. Show the distances between the corner as previously restored or reestablished and (1) the corner as restored or reestablished, and (2) to at least 4 of the witness monuments shown on the drawing in (a), above.

(E) Was the corner reestablished through lost corner proportionate methods? If so, show the method, including the directions and distances to other public land survey corners used as evidence or used for proportioning the corner location.

I, Donald Barnes, hereby certify that the corner points as identified by the corner code index were, in a field survey on, AUGUST 6 1991, established, re-established, monumented, re-monumented, recovered or restored as expressed below and in conformance with the regulations and rules as required in the current manual of survey instructions of the United States Department of Interior, Bureau of Land Management.

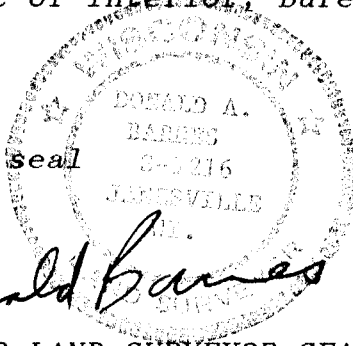

*Donald Barnes*

AFFIX YOUR LAND SURVEYOR SEAL

COUNTY SURVEYOR FILING DATA

Date of computer entry \_\_\_\_\_

Date microfilmed \_\_\_\_\_

Number of included sheets 1  
CORNER CODE

T 2

W 1/4 CDR

BARNES 1984 1485.37

SI-30-19W 2653.79

NW CDR

NE CDR  
SEC 36 ALUM

SI-38-57W 1168.43  
ORIG 1117.38

1/16TH  
STONE

SI-26-13W 2625.63

W 1/4 CDR

POLY

E 1/4 CDR  
SEC 36 ALUM

SI-20-23W 1519.84

SI-17-06W 2642.99

SW CDR

SE CDR  
SEC 36

ORIG 1133.88  
ALUM

W 1/4 CDR

SI-27-30V 2657.50  
LEE 1869 2655.84 VAR 7-45  
SI-27-30V 1325.61  
RUGER 1877 1325.78  
SI-26-55W 1325.78  
RUGER 1877 1325.78  
SI-27-30V 2629.40  
LEE 1869 2627.13  
RUGER 1874 2627.13

RUGER 1877 1499.52  
ORIG 2831.14  
S87-54-12E 1500.71  
1499.52 LEE 1869 VAR 6-54  
BARNES 1984 S87-54-12E 1500.63

1/16TH  
CDR

1308.78 LEE 1869 VAR 6-54  
S87-33-55E 1310.10  
BARNES 1984 1310.10

N 1/4 CDR

ORIG 2640  
1320.79 BARNES 1984 1320.79  
1318.68 LEE 1869 1318.68 VAR 6-40  
S88-03-13E 2641.44

NE CDR

R/R

SI-27-30V 1325.78  
RUGER 1877 1325.78  
SI-26-55W 1325.78  
RUGER 1877 1325.78

1523.24  
RUGER 1877 1521.96  
LEE 1869 1521.96

1313.16

NO-28-22E 1326.28

1326.60 LEE 1869  
NO-28-22E 1331.60

RUGER 1877 1326.60  
S88-24E 1312.

LEE 1869 2643.30  
S0-20E 2645.7

KERCH 1335  
BARNES 1976 1335 (FENCE)  
LEE 1869 1336.01  
1334.9

XXXXXXXXXX

LEE 1869 1336.01  
KERCH 1335  
1335 FENCE

1544.40 LEE 1869  
S87-53-50E 1546.18  
RUGER 1877 1544.40

STONE

1/16TH

FENCE INT.

LEE 1869 2630.10  
S0-30-08V 2636.48

S0-30V 2630.3

KERCH 333.75  
334  
KERCH 1668.75  
S88-00E 1668.4 (FENCE)

KERCH 1001.25  
S88-18E 1001.2  
(FENCE)

2640.88 1/4 LINE  
2637.9 FENCE INT  
KERCH 1911 2640.7

KERCH 1002.68  
FENCE 1002

MON BOX

ALUM

BARNES 1976 2903.3  
LEE 1869 1588.62  
ORIG 2913.90  
S88-41-09E 2905.74  
LEE 1869 2904.0

LEE 1869 1313.38 S 1/4  
CDR

BARNES 1976 1326.02  
RUGER 1874 1324.13

BARNES 1976 2674.5  
KERCH 1911 2673.8  
S87-44-54E 2674.47  
ORIG 2640

SE CDR

S0-16-39E 2643.81  
CHURCH 1855 2649.24

S0-25-00V 2647.53  
CHURCH 1855 2640

◇ COMPUTED POSITION WHICH MAY NOT REPRESENT THE ACTUAL CORNER AS MONUMENTED.

□ USED PREVIOUS FIELD MEASUREMENTS TO COMPUTE THE LOCATION.

SEC 19

SEC 30

SEC 31

2 OF 2



T2