

# U.S. PUBLIC LAND SURVEY MONUMENT RECORD

For Public Land Survey Corners in:

WI ADMINISTRATIVE CODE A-E 7.08 REQUIREMENT

T. 1N., R. 11E

### CORNER CODE INDEX

A	2	3	4	5	6	7	8	9	10	11	12	13	14	15	16	17	18	19	20	21	22	23	24	25
B																								
C	6																							
D																								
E																								
F	7																							
G		8																						
H																								
I																								
J																								
K	18																							
L		17																						
M																								
N																								
O																								
P	19																							
Q		20																						
R																								
S																								
T	30																							
U		29																						
V																								
W																								
X	31																							
Y		32																						
Z																								

NEWARK TWP  
ROCK COUNTY WI

IF AVAILABLE  
ROCK COUNTY COORDINATES PREFERRED

North \_\_\_\_\_ Elev. \_\_\_\_\_

East \_\_\_\_\_

Hor. Datum \_\_\_\_\_ Vert. Datum \_\_\_\_\_

LATITUDE \_\_\_\_\_ ELLIPS. HT. \_\_\_\_\_

LONGITUDE \_\_\_\_\_

GPS (X) \_\_\_\_\_ TRAVERSE (X) \_\_\_\_\_

BASED ON THE FOLLOWING CONTROL:

PLACE MONUMENT SYMBOL  AT PROPER LOCATION ON ABOVE INDEX

CORNER MONUMENT

WITNESS MONUMENT

(a)

BEARINGS ARE BASED ON:

FIELD BOOK \_\_\_\_\_ PAGE # \_\_\_\_\_

SHEET 1 OF 2

SHOW A PLAN VIEW DRAWING DEPICTING THE CORNER MONUMENT AND SURROUNDING PHYSICAL FEATURES, INCLUDING THE EXCAVATION AREA AND DEPTH.

PLANNING & ZONING COMMITTEE ADOPTED THE ABOVE FORM ON 12/2/1982

CORNER CODE R-17(1)

NE589

(B) Describe any record evidence, monument evidence, occupational evidence, testimonial evidence or any other material evidence you considered, and whether the monument was found or placed.

1834 MILLER

PG 21

EAST RANDOM BETWEEN SECS 22 & 27

1980 ENTER MARSHY GROUND SW  
4290 LEAVE SAME  
4818 BROOK 6.6' S  
5276.04 INTERSECT SEC LINE 12.54' NORTH OF POST  
LAND LEVEL MOSTLY LOW AND WET 2ND RATE TIMBER OAK &  
HICKORY  
2638.02 SET 1/4 SEC POST YELLOW OAK 6 IN N52E 134.64'; BUR OAK 5 IN N35E  
168.96'  
4536.84 BUR OAK 18 IN  
5276.04 SEC COR.

PG 16

NORTH BETWEEN 22 & 23

300.96 BUR OAK 12 IN  
627 BROOK 6.6' SW  
676.5 SAME BROOK NE  
722.7 SAME BROOK S.W.  
2640 SET 1/4 SEC POST BUR OAK 8 IN S19E 59.4'; YELLOW OAK 10 N6W 66'  
2814.9 YELLOW OAK 10 IN  
4643.76 BUR OA 18 IN  
5256.24 BUR OAK 12 IN  
5280 SET POST COR OF SEC 14,15,22,23 BUR OAK 18 S50E 29.04'; BUR OAK 15  
N60W 23.76' LAND ROLLING (SLIGHTLY) 2ND RATE TIMBER OAK &  
HICKORY. OAK & HAZEL UNDERGROWTH

PG 15

NORTH BETWEEN 26 & 27

330 LEAVE POINT. TIMBER FOR LOW GROUND  
2640 SET 1/4 SEC POST YELLOW 6 S4-30W 405.24'; BUR OAK 10 S2E 212.5'  
3234 LEAVE LOW GROUND  
3613.5 BUR OAK 18  
4276.8 BUR OAK 18  
\*5280 SET POST CORNER OF SECS 22,23,26,27 LAND SAME AS LAST  
NORTHING. \*BEARINGS BUR OAK 18 N71E 54.78'; YELLOW OAK 10  
S33W 29.7'

PG 15

EAST RANDOM BETWEEN SECS 23 & 26

5270.76 INTERSECT SEC LINE 10.56' NORTH OF POST LAND ROLLING 2ND  
RATE TIMBER OAK & HICKORY OAK & HAZEL UNDERGROWTH  
WEST CORRECTED BETWEEN SECS 23 & 26

2635.38 1/4 SEC A YELLOW OAK 16 IN DIA  
3217.5 BUR OAK 8 IN DIA  
4676.76 BUR OAK 16 IN DIA  
5270.76 SEC COR

1871 COLLIN'S REMONUMNETATION NOTES

PG 153

NORTH BETWEEN 22 & 23 VARIATION 4-30

620.4 CREEK  
2620.2 INTERSECT 1/4 LINE 5.94' EAST OF CORNER SET 1/4 STONE BY STUMP  
OF WITNESS TREE. CORRECTED VARIATION 4-22  
CONTINUED NORTH VARIATION 5  
5249.64 SET STONE FOR CORNER OF 14,15,22,23 BY ROOTS OF WITNESS  
TREES.

PG 165

WEST BETWEEN 22 & 27 VARIATION 4-30 ON  
OFFSET 11.88' SOUTH

2655.18 INTERSECT 1/4 LINE 5.94' NORTH OF CORNER. SET 1/4 STONE BY  
WITNESS TREE AND STUMP. CORRECTED VARIATION 4-38  
CONTINUED WEST VARIATION 3 ON OFFSET 13.2' NORTH  
5313.66 INTERSECT SECTION LINE 24.42' NORTH OF CORNER.  
CORRECTED VARIATION 3-15

*Donald Barnes*

7-02-01

SHEET 1 OF 2

R-17(1)

- 2628.12 INTERSECT 1/4 LINE 4.62' NORTH OF CORNER WHICH IS A YELLOW OAK 28 INCHES IN DIAMETER. SET STONE 2.64' NORTH OF CORNER MARKED 1/4 S COR 2.64'. CORRECTED VARIATION 6-54 {1/4 SEC A YELLOW OAK 16 IN DIA ORIG SURVEY} CHECK HIS TWP PLAT TO SEE IF DISTANCE IS TO CORNER OR HIS STONE)  
CONTINUED NORTH(SHOULD BE EAST) VARIATION 6-30
- 5248.32 INTERSECT SEC. LINE 23.1' NORTH OF CORNER CORRECTED VARIATION 7. OCT 19, 1871

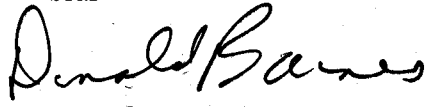
- 2636.7 SET 1/4 STONE BY STUMP OF WITNESS TREE.  
CONTINUED NORTH VARIATION 7-15
- 5273.4 SET STONE FOR CORNER OF 22, 23, 26, 27 BY STUMP OF WITNESS TREE.
- 1930 BATTERMAN VOL 3 PG 174 1327.6 WEST TO 1/16TH COR.
- 1930 BATTERMAN VOL 3 PG 175 FD STONE MON. & REFERENCED SAME.
- 1931 BATTERMAN VOL 3 PG 190 FD STONE AT NW SEC 26 BROKEN OFF. SET IRON PIPE ON TOP. 811.26' NORTH OF CENTER OF PVMT OF HWY 14.
- 1955 SHIMEALL #3218 & #3217 2655.2 TO N 1/4 COR SEC 27
- 1977 BARNES VOL 5 PG 360 FD NAIL & 1" IP. FD CUT STONE 2.0' DEEP. SET ALUM. MON. & REFERENCED. FD PK SOUTH AND EAST OF A POINT 3.05' SOUTH OF L.S. DUG 3' DEEP AT THAT POINT & FD NOTHING.
- 1979 BARNES VOL 5 PG 537 2654.91 TO S 1/4 COR SEC 22, 2632.47 TO W 1/4 COR SEC 26 ANGLE OF 87-17-38 @ E 1/4 COR SEC 27 FROM W 1/4 COR SEC 27 TO NE COR SEC 27, ANGLE OF 180-11-23 @ W 1/4 COR SEC 26 FROM NW TO SE CORNERS OF SEC 26, & ANGLE OF 93-10-35 @ NE COR FROM E 1/4 TO N 1/4 CORNERS OF SEC 27.
- 1982 LEUENBERGER CSM 11 PG 71 2632.48 TO NE COR SEC 27.
- 1991 BARNES R-17. FD ALUM. MON @ CENTER OF PVMT & 3 REFERENCE TIES. SET 4<sup>TH</sup> TIE. RD PAVING PROJECT WILL INVOLVE THIS CORNER. DID NOT ACCEPT NOR REJECT MONUMENT. REFERENCED FD MON SO IT WOULD NOT BE DESTROYED BY THE PAVING PROJECT.

FD ALUM. MON. WITH TOP BROKE OFF.

C) Was the corner restored through acceptance of (1) an obliterated evidence location, or, (2) a found perpetuated location?

ACCEPTED FD PERPETUATED LOCATION.

I, Donald Barnes, hereby certify that the corner location as identified by the corner code index was determined by me under my direction and control and that this U.S. Public Land Survey Monument Record is correct and complete to the best of my knowledge and belief.

seal  
  
 7-02-01  
 emboss

SHEET 2 OF 2

CORNER CODE **R-17(1)**

A-E 7.08 REQUIREMENT