


PLAT AND RECORD

Of a Survey on Section 8 T 3 R 10 E. of the 4 P. M. in Magnolia Township
 Rock County, Wisconsin, made December the 20th 1855

I hereby certify that the following is a correct record of said survey as made by me.

COUNTY BUILDING
 IN CITY OF BELOIT

(Signed) Joseph Church
JAC County Surveyor.

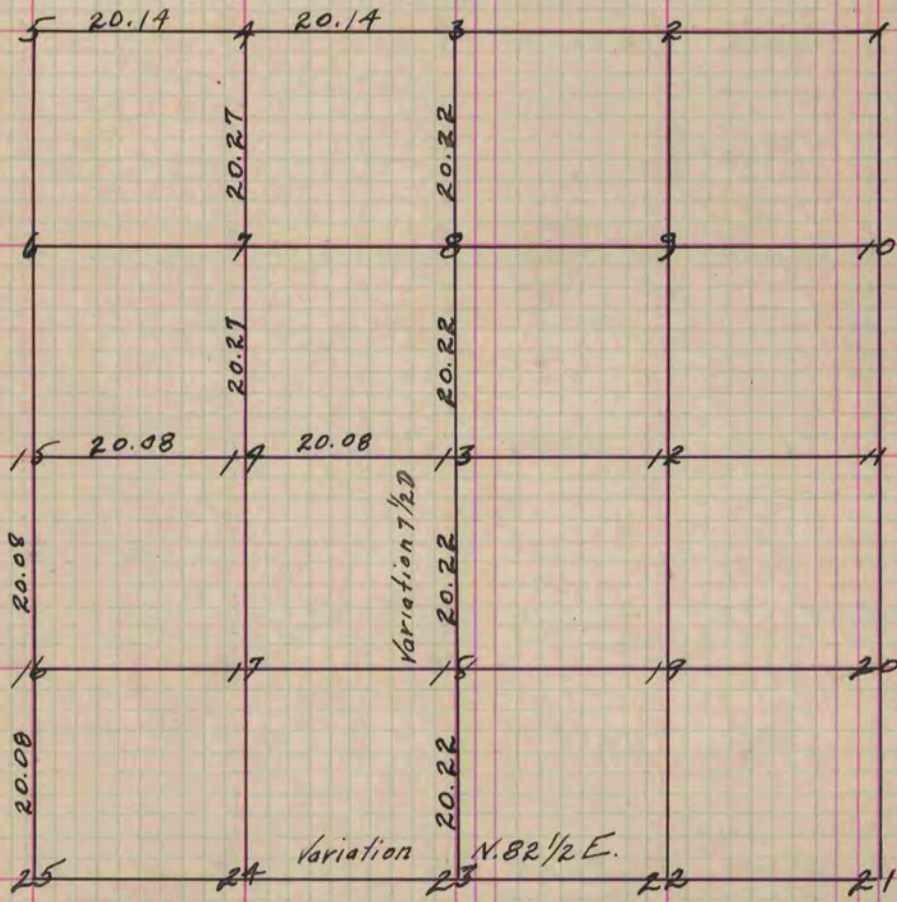

- Fig. 13 Centre of Section. Buried stone no bearings in centre of road.
 " 4 Wit. to stake Br. O. 14 S. 31 E. 61
 Red O. 14 N. 32 W. 38
 " 18 W. O. 24 N. 64 1/2 W. 75 C
 24 S. 51 1/2 E. 54 1/2 C
 " 17 Red O. 8 S. 72 1/2 W. 40
 W. O. 20 S. 78 E. 45 1/2 C

Copied from Page 55 Vol. 1 Original County Surveyors Record