

# U.S. PUBLIC LAND SURVEY MONUMENT RECORD


For Public Land Survey Corners in the  
T. 3N., R. 12E.

## CORNER CODE INDEX

	1	2	3	4	5	6	7	8	9	10	11	12	13	14	15	16	17	18	19	20	21	22	23	24	25
A																									
B																									
C	6																								
D		5																							
E			4																						
F				3																					
G					2																				
H																									
I																									
J																									
K																									
L	7																								
M		8																							
N			9																						
O				10																					
P					11																				
Q						12																			
R							13																		
S								14																	
T									15																
U										16															
V											17														
W												18													
X													19												
Y														20											
Z															21										
																22									
																	23								
																		24							
PLACE MONUMENT SYMBOL (◆) AT PROPER LOCATION ON ABOVE INDEX

### EXAMPLE

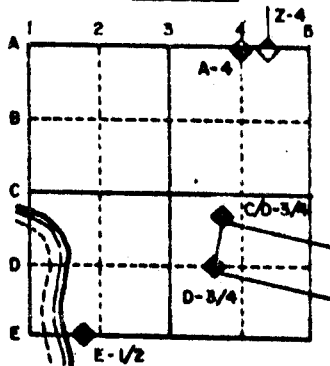

JANESVILLE TWP  
ROCK COUNTY WI

### IF AVAILABLE STATE PLANE COORDINATES

North (Y) \_\_\_\_\_ Eleve. (Z) \_\_\_\_\_  
 East (X) \_\_\_\_\_ Zone \_\_\_\_\_  
 Hor. Datum \_\_\_\_\_ Vert. Datum \_\_\_\_\_

d.)

◆ CORNER MONUMENT

○ WITNESS MONUMENT

BEARINGS ARE BASED ON:

# MICROFILMED

SHEET \_\_\_ OF \_\_\_

CORNER CODE: X16

# RESERVATION OF LANDMARKS

BOOK \_\_\_\_\_ PAGE 2

SECTION 59,635(7) WISCONSIN STATUTES  
COUNTY ROCK

TOWN JANESVILLE


HIGHWAY S.T.H. 11

SECTION NO. 34


T. 3 N., R. 12 E.

TYPE OF LANDMARK 5/8" IRON PIN

LOCATION INDICATED ON SKETCH X

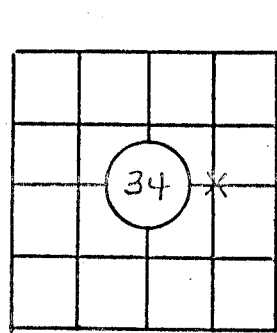

LOCATION SKETCH

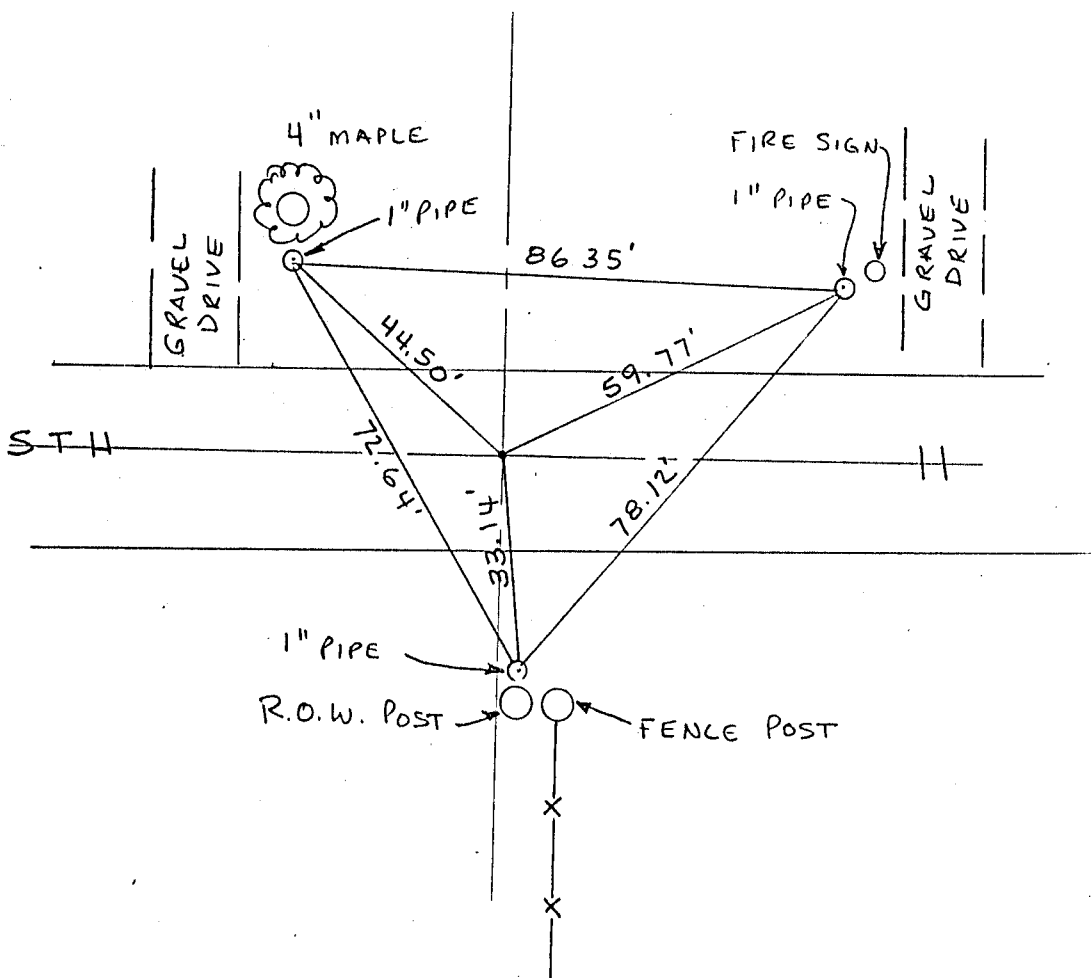

Located and referenced by: R.F.B. 3-11, 1970

Field notes recorded 3-11, 1970 in Book 152 on Page 24

Copy sent to County Surveyor's Office \_\_\_\_\_, 19\_\_\_\_

Drawn by: \_\_\_\_\_

151-152

X 16