


(b.) Describe any record evidence, monument evidence, occupational evidence, testimonial evidence or any other material evidence you considered, and whether the monument was found or placed.

- 186? LOCKE VOL 1 PG 177 POST IN MOUND.
 - 1872 LEE VOL 2 PG 83 FOUND OLD STAKE & STUMP OF BT SET BL OAK STAKE.
 - 1877 RUGER VOL 2 PG 225 FOUND STAKE SURROUNDED BY HH STONES AS SET BY SELF IN FORMER SURVEY.
 - 1877 RUGER VOL 2 PG 226 FOUND STAKE AS SET BY SELF IN FORMER SURVEY
 - 1900 KERCH VOL 3 PG 1 FOUND STONE.
 - 1928 SUNNY VOL 6 PG 64 "CONWAY'S ADD". SHOWS CORNER AS A PIPE.
 - 1952 KAHUSKE VOL 13 PG 21A "SINNISSIPPI HILLS ADD" SUBDIVISION IS CONNECTED TO THE CORNER.
 - 1969 LEE PLAT OF SURVEY. FOUND PIPE.
- I FOUND TWO 2" PIPES IN CONCRETE. I ACCEPTED THE ONE THAT WAS IN HARMONY WITH THE SINNISSIPPE HILLS ADD. SUBDIVISION.

(c.) Was the corner restored through acceptance of (1) an obliterated evidence location, or, (2) a found perpetuated location?
ACCEPTED FOUND PERPETUATED LOCATION.


(d.) Describe any material discrepancy between the location of the corner as restored or reestablished and the location of that corner as previously restored or reestablished by distance and direction. Show the discrepancy on the plan view drawing under (b), above. Show the distances between the corner as previously restored or reestablished and (1) the corner as restored or reestablished, and (2) to at least 4 of the witness monuments shown on the drawing in (b), above.

THERE IS A DISCREPANCY BETWEEN THE LOCATION OF THE CORNER AS RESTORED WITH ANOTHER PIPE.

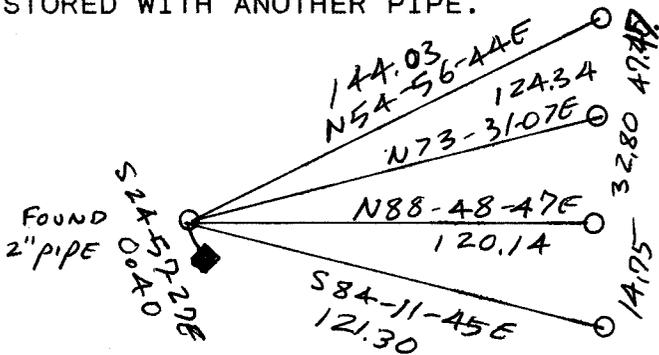


(e.) Was the corner reestablished through lost corner proportionate methods? If so, show the method, including the directions and distances to other public land survey corners used as evidence or used for proportioning in determining the corner location.

N/A

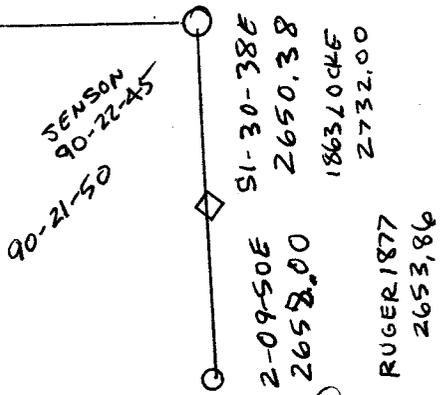

I, Donald Barnes, hereby certify that the corner points as identified by the corner code index were, in a field survey on May 19 1988, established, re-established, monumented, re-monumented, recovered or restored as expressed below and in conformance with the regulations and rules as required in the current manual of survey instructions of the United States Department of Interior, Bureau of Land Management.

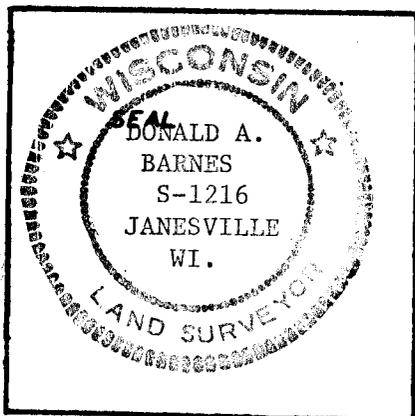

COUNTY SURVEYOR FILING DATA

Date of Computer Entry _____

Date Received _____

Date Microfilmed _____

Treasurer's Receipt No. _____

Number of Included Sheets _____

AFFIX YOUR LAND SURVEYOR SEAL. CORNER CODE T17