

# PUBLIC LAND SURVEY MONUMENT RECORD

For Public Land Survey Corners in the


T. 1N., R. 13E.

## CORNER CODE INDEX

	1	2	3	4	5	6	7	8	9	10	11	12	13	14	15	16	17	18	19	20	21	22	23	24	25
A																									
B																									
C																									
D																									
E																									
F																									
G																									
H																									
I																									
J																									
K																									
L																									
M																									
N																									
O																									
P																									
Q																									
R																									
S																									
T																									
U																									
V																									
W																									
X																									
Y																									
Z																									

PLACE MONUMENT SYMBOL (◆) AT PROPER LOCATION ON ABOVE INDEX

### EXAMPLE

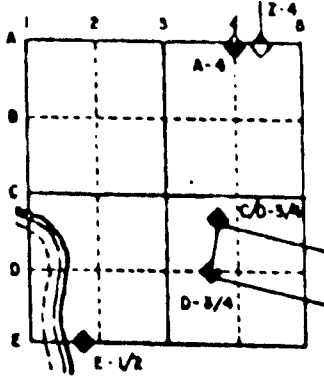

TURTLE TWP  
ROCK COUNTY WI

IF AVAILABLE  
STATE PLANE COORDINATES

North (Y) 216,874.52    Eleve. (Z) \_\_\_\_\_  
 East (X) 501,406.14    Zone \_\_\_\_\_  
 Hor. Datum COUNTY    Vert. Datum \_\_\_\_\_

◆ CORNER MONUMENT

○ WITNESS MONUMENT

BEARINGS ARE BASED ON:

TU563

(B) Describe any record evidence, monument evidence, occupational evidence, testimonial evidence or any other material evidence you considered, and whether the monument was found or placed.

1836 LYON SET POST CORNER 17,18,19,&20 B OAK 14 N17W 26 & BUR OAK 9 S66W 188.

1911 KERCH VOL 3 PG 64 FOUND OLD STAKE & SW BT. SET 2" GAS PIPE 36". 2637.6 TO N 1/4 COR SEC 20,2649.4 TO W 1/4 COR SEC 20,& ANGLE OF 90-32-40 AT NW COR SEC 20 FROM N 1/4 TO W 1/4 CORNERS OF SEC 20.

1958 BATTERMAN VOL 3 PG 509 STATES NOTHING ABOUT CORNER 2649.48 TO S 1/4 CORNER OF SEC 18.

FOUND DISK IN CONCRETE MONUMENT. 2638.96 (REC 2637.6) TO N 1/4 COR SEC 20,2649.39 (REC 2649.4) TO W 1/4 COR SEC 20,& ANGLE OF 90-31-41 (REC 90-32-40) AT NW COR SEC 20 FROM N 1/4 COR TO W 1/4 CORNERS OF SEC 20.

C) Was the corner restored through acceptance of (1) an obliterated evidence location, or, (2) a found perpetuated location?  
ACCEPTED FOUND PERPETUATED LOCATION.

D) Describe any material discrepancy between the location of the corner as restored or reestablished and the location of that corner as previously restored or reestablished by distance and direction. Show the discrepancy on the plan view drawing under (a), above. Show the distances between the corner as previously restored or reestablished and (1) the corner as restored or reestablished, and (2) to at least 4 of the witness monuments shown on the drawing in (a), above.

(E) Was the corner reestablished through lost corner proportionate methods? If so, show the method, including the directions and distances to other public land survey corners used as evidence or used for proportioning the corner location.  
NO

I, Donald Barnes, hereby certify that the corner points as identified by the corner code index were, in a field survey on, 1995, established, re-established, monumented, re-monumented, recovered or restored as expressed below and in conformance with the regulations and rules as required in the current manual of survey instructions of the United States Department of Interior, Bureau of Land Management.

seal

*7/14/95*  
*Donald Barnes*

COUNTY SURVEYOR FILING DATA

Date of computer entry \_\_\_\_\_

Date microfilmed \_\_\_\_\_

Number of included sheets \_\_\_\_\_

CORNER CODE

EMBOSS LAND SURVEYOR SEAL

*NS*

3/4X24 REROD  
WITH PLASTIC CAP  
3.6' WEST OF WEST EDGE  
PVT, 100' +/- NORTH OF NORTH  
EDGE OF BRIDGE

STA "857"

3/4X24 REROD  
WITH PLASTIC CAP  
12' WEST OF WEST EDGE PVT

STA "866"

N40-37-37E 410.37

N14-26-42E 949.14

87.809 E05-51-15-2S

N39-36-42E 843.32  
CTH "S"

SE COR  
SEC 18

S89-53-45E 2638.96

TO S 1/4 COR SEC 17


FD DISK IN  
CONCRETE MON.

TO E 1/4 COR SEC 19  
S0-37-56W 2649.39

STA "863"

N85-46-35E 569.63

R/R 7.2' WEST OF WEST EDGE  
PVT CTH "S", 3 SOUTH  
CENTER MURPHEY WOODS RD PVT

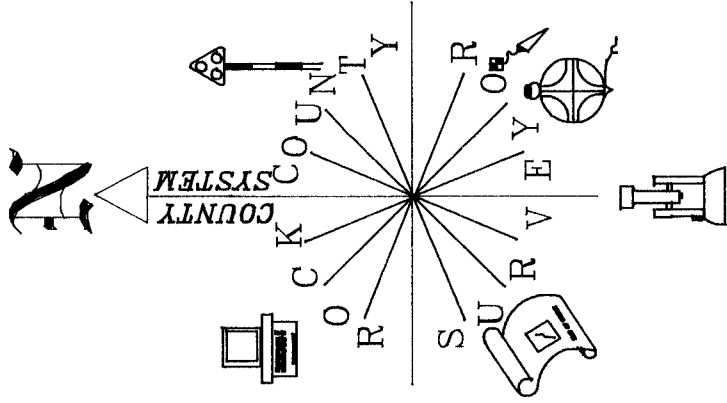

Donald Burnes

7/14/95

N5