

# PUBLIC LAND SURVEY MONUMENT RECORD

For Public Land Survey Corners in the


T. 1 N., R. 13 E.

## CORNER CODE INDEX

	1	2	3	4	5	6	7	8	9	10	11	12	13	14	15	16	17	18	19	20	21	22	23	24	25
A																									
B																									
C																									
D																									
E																									
F																									
G																									
H																									
I																									
J																									
K																									
L																									
M																									
N																									
O																									
P																									
Q																									
R																									
S																									
T																									
U																									
V																									
W																									
X																									
Y																									
Z																									

PLACE MONUMENT SYMBOL (◈) AT PROPER LOCATION ON ABOVE INDEX

### EXAMPLE

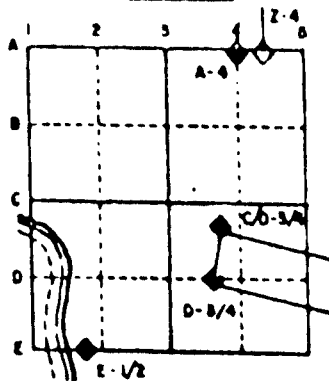

TURTLE TWP  
ROCK COUNTY WI

IF AVAILABLE  
STATE PLANE COORDINATES

North (Y) 216,662.63      Elevation (Z) \_\_\_\_\_  
 East (X) 514,637.96      Zone \_\_\_\_\_  
 Hor. Datum COUNTY      Vert. Datum \_\_\_\_\_

◈ CORNER MONUMENT

○ WITNESS MONUMENT

BEARINGS ARE BASED ON:

TU 568

(B) Describe any record evidence, monument evidence, occupational evidence, testimonial evidence or any other material evidence you considered, and whether the monument was found or placed.

1836 LYONS SET QUARTER SECTION POST BLACK OAK 13, N67E 54 & WHITE OAK 22 N14W 60. CALLS FOR 2634.72 TO SE & SW CORNERS OF SEC 15.

1972 LEE VOL 4 PG 585 CALLS FOR PIPE 2647.29 TO NW & 2657.74 TO NE CORNERS OF SEC 22, ANGLE OF 91-28-30 AT N 1/4 COR FROM S 1/4 COR TO NW CORNERS OF SEC 22, ANGLE OF 88-29-13 AT N 1/4 COR FROM NE COR TO S 1/4 CORNERS OF SEC 22, 2654.24 TO CENTER OF SEC 22, ANGLE OF 88-34-30 AT NW COR SEC 22 FROM N 1/4 COR TO W 1/4 CORNERS OF SEC 22, & ANGLE OF 91-28-02 AT NE COR OF SEC 22 FROM E 1/4 COR TO N 1/4 CORNERS OF SEC 22.

FOUND 1" PIPE 8" ABOVE GROUND. PLACED CARSONITE POST NEXT TO MONUMENT. MONUMENT IS EAST OF GARAGE AT HOUSE #9521. 2647.48 (REC 2647.29) TO NW COR SEC 22, 2657.64 (REC 2657.74) TO NE COR SEC 22, ANGLE OF 88-34-28 (REC 88-34-30) AT NW COR SEC 22 FROM N 1/4 COR TO W 1/4 CORNERS OF SEC 22, ANGLE OF 91-28-30 (REC 91-28-02) AT NE COR SEC 22 FROM E 1/4 TO N 1/4 CORNER OF SEC 22, ANGLE OF 88-28-57 (REC 88-29-13) AT N 1/4 COR SEC 22 FROM NE TO S 1/4 COR SEC 22, & ANGLE 91-28-20 (REC 91-28-30) AT N 1/4 COR 22 FROM S 1/4 COR TO NW CORNERS OF SEC 22.

C) Was the corner restored through acceptance of (1) an obliterated evidence location, or, (2) a found perpetuated location?  
ACCEPTED FOUND MONUMENT.

D) Describe any material discrepancy between the location of the corner as restored or reestablished and the location of that corner as previously restored or reestablished by distance and direction. Show the discrepancy on the plan view drawing under (a), above. Show the distances between the corner as previously restored or reestablished and (1) the corner as restored or reestablished, and (2) to at least 4 of the witness monuments shown on the drawing in (a), above.

(E) Was the corner reestablished through lost corner proportionate methods? If so, show the method, including the directions and distances to other public land survey corners used as evidence or used for proportioning the corner location.  
NO

I, Donald Barnes, hereby certify that the corner points as identified by the corner code index were, in a field survey on 1994, established, re-established, monumented, re-monumented, recovered or restored as expressed below and in conformance with the regulations and rules as required in the current manual of survey instructions of the United States Department of Interior, Bureau of Land Management.

seal  
*Donald Barnes*  
*6/12/95*

EMBOSS LAND SURVEYOR SEAL

COUNTY SURVEYOR FILING DATA

Date of computer entry \_\_\_\_\_

Date microfilmed \_\_\_\_\_

Number of included sheets \_\_\_\_\_

CORNER CODE

*N15*

