

U.S. PUBLIC LAND SURVEY MONUMENT RECORD

For Public Land Survey Corners in the


T. 1 N., R. 13 E

CORNER CODE INDEX

1	2	3	4	5	6	7	8	9	10	11	12	13	14	15	16	17	18	19	20	21	22	23	24	25	
A																									
B	6	5	4	3	2																				
C																									
D	7	8	9	10	11	12																			
E																									
F																									
G	13	14	15	16	17	18	19	20	21	22	23	24													
H																									
I																									
J																									
K																									
L	19	20	21	22	23	24																			
M																									
N																									
O																									
P	29	28	27	26	25																				
Q																									
R																									
S																									
T	30	29	28	27	26	25																			
U																									
V																									
W																									
X	31	32	33	34	35	36																			
Y																									
Z																									

PLACE MONUMENT SYMBOL (◆) AT PROPER LOCATION ON ABOVE INDEX

EXAMPLE

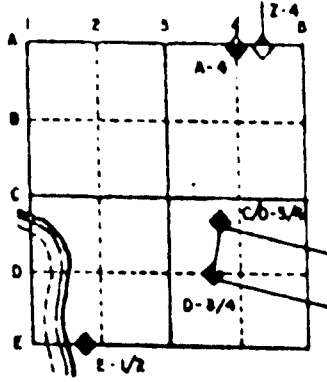

TURTLE TWP
ROCK COUNTY WI

IF AVAILABLE
STATE PLANE COORDINATES

North (Y) 214, 225, 29 Elev. (Z) _____
East (X) 501, 376, 91 Zone _____
Hor. Datum COUNTY Vert. Datum _____

◆ CORNER MONUMENT

○ WITNESS MONUMENT

BEARINGS ARE BASED ON:

(B) Describe any record evidence, monument evidence, occupational evidence, testimonial evidence or any other material evidence you considered, and whether the monument was found or placed.

- 1859 HOBART VOL 1 PG 105 SHOWS BEARING TREES, 2651.22 TO CENTER OF SECTION 19. TRUE NORTH BEARING OF N89-57W FROM E 1/4 TO W 1/4 CORNERS OF SECTION 19.
- 1911 KERCH VOL 3 PG 64 SET 2" GAS PIPE. CALLS FOR 2649.4 TO NW, 2649.3 TO SW CORNERS OF SECTION 20. ANGLE 90-32-20 AT NW 20 FROM N 1/4 TO W 1/4 COR, ANGLE 89-38-15 AT SW COR FROM W 1/4 TO S 1/4, & ANGLE 89-40-30 AT W 1/4 COR FROM NW TO E 1/4 CORNERS OF SECTION 20. 2658.85 FROM N 1/4 COR TO CENTER OF SECTION 20 AND ANGLE 89-43-30 AT CENTER FROM N 1/4 TO E 1/4 CORNERS OF SECTION 20.
- 1911 KERCH VOL 3 PG 69 FOUND GAS PIPE, SEE PAGE 64.
- 1911 KERCH BK7 PG 47 "PLAT OF THE MORGAN FARM". SAME INFORMATION AS IN VOL 3 PG 61.
- 1958 SHEMEALL BK 19 PG 17 "CANTERBURY WOODS" 2" PIPE. 198.16 WEST OF LOT CORNER. 89-40-30 ANGLE AT W 1/4 CORNER FROM CENTER TO SW CORNERS OF SECTION 20. AT BEND IN WEST COLLINGS & CHATSWORTH ROADS.
- 1966 BENNETT CSM VOL 1 PG 137 FOUND 2" PIPE
- 1967 LEE BK 23 PG 29 "BOOTMAKER MANOR FIRST ADD" 143.25 EAST & 160.95 WEST OF LOT CORNER. SOUTH R/W LINE OF CHATSWORTH PROJECTED WEST & BETWEEN WEST COLLINGWOOD & LEE LANE ROADS.
- 1989 LEE BK 32 PG 59 "REGAL OAKS FIRST ADD" 2648.28 TO SW CORNER OF SECTION 20.

DUG & FOUND UNDERGROUND CABLE WIRE. DID NOT FIND 2" PIPE.

C) Was the corner restored through acceptance of (1) an obliterated evidence location, or, (2) a found perpetuated location?

RESTORED THROUGH ACCEPTANCE OF OBLITERATED EVIDENCE LOCATION. USED LOT CORNERS TO ESTABLISH POSITION THAT WAS IN HARMONY WITH RECORD DISTANCES. DID NOT PLACE A MONUMENT BECAUSE OF THE FENCE POSTS AND UNDERGROUND CABLES. THIS IS 2649.39' FROM THE NW CORNER AND 2648.36' OF SECTION 20.

D) Describe any material discrepancy between the location of the corner as restored or reestablished and the location of that corner as previously restored or reestablished by distance and direction. Show the discrepancy on the plan view drawing under (a), above. Show the distances between the corner as previously restored or reestablished and (1) the corner as restored or reestablished, and (2) to at least 4 of the witness monuments shown on the drawing in (a), above.

(E) Was the corner reestablished through lost corner proportionate methods? If so, show the method, including the directions and distances to other public land survey corners used as evidence or used for proportioning the corner location.

NO

I, Donald Barnes, hereby certify that the corner points as identified by the corner code index were, in a field survey on, October 14, 1994, established, re-established, monumented, re-monumented, recovered or restored as expressed below and in conformance with the regulations and rules as required in the current manual of survey instructions of the United States Department of Interior, Bureau of Land Management.

seal

Donald Barnes
OCT 20, 1994

COUNTY SURVEYOR FILING DATA



Date of computer entry _____

Date microfilmed _____

Number of included sheets 2
CORNER CODE

AFFIX YOUR LAND SURVEYOR SEAL

Donald Barnes
 OCT 20, 1994

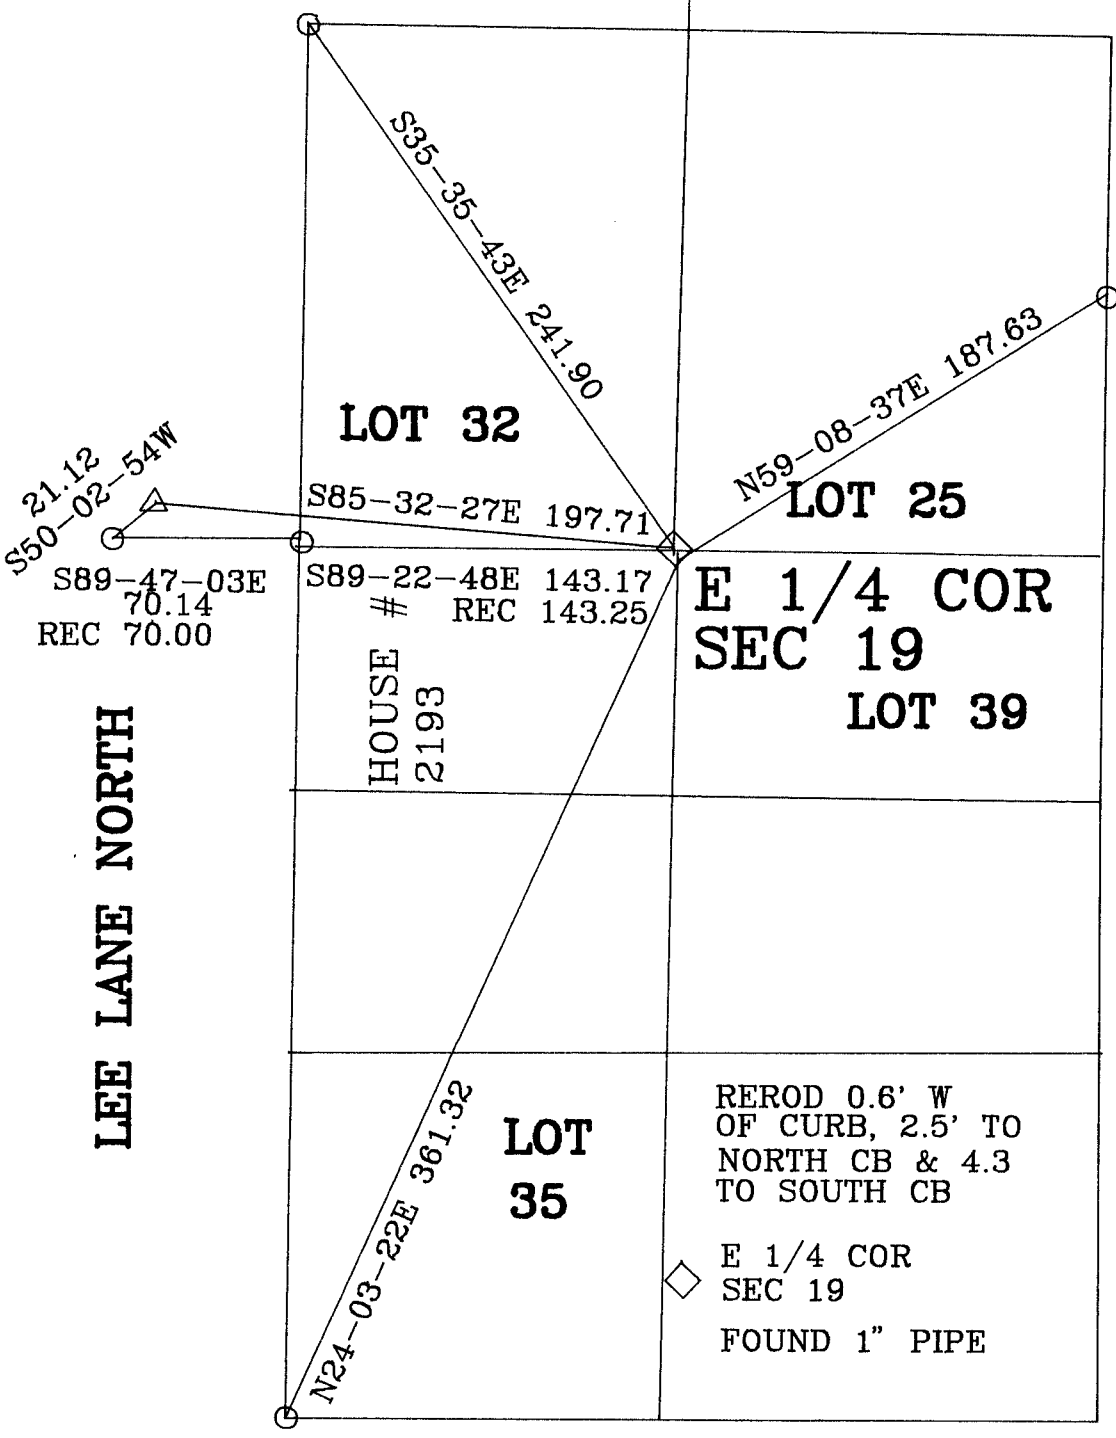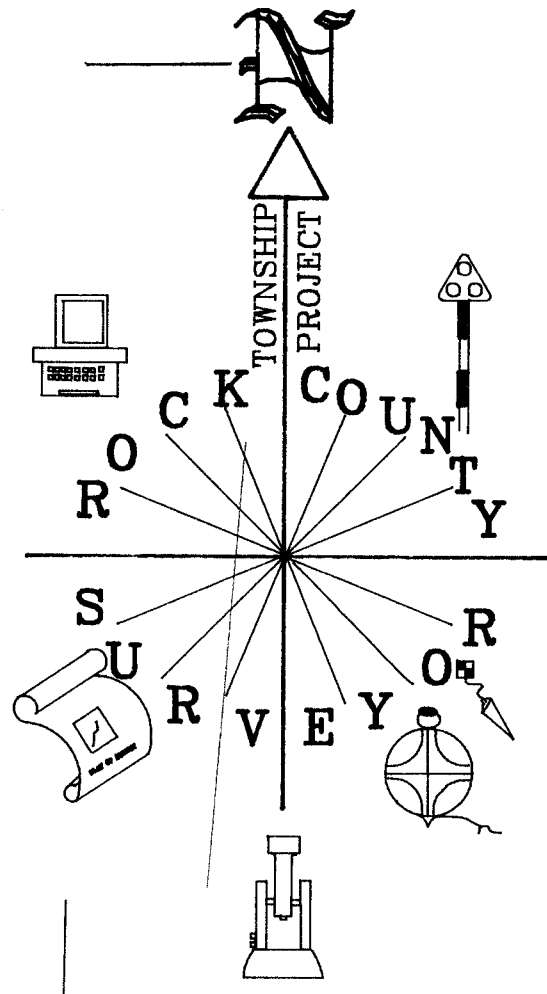

W. COLLINGSWOOD

CHATSWORTH

LEE LANE NORTH

AUSTIN PLACE

