Paper weight- 32# 25% Rag Ledger (minimum)


Black nonfading ink required

 $\mathbf{U}.\mathbf{S}.$

SURVEY TUBLIC MONUMENT RECORD

For Public Land Survey Corners in the T. LN., R. 13 E

CORNER CODE INDEX

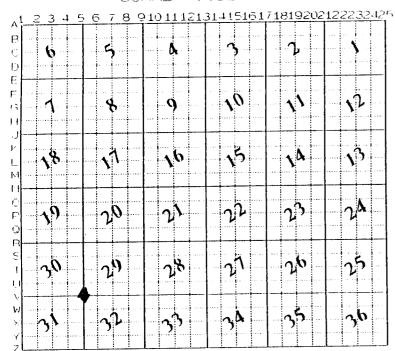

TURTLE ROCK COUNTY WI

IF AVAILABLE ROCK COUNTY COORDINATES PERFERRED

Morth 206, 281.77 Elev.

East 501,406,49

Hor. Datum COUNTY Vert. Datum ____

TRAVERSE (X) X GPS (X) ____ BASED ON THE FOLLOWING CONTROL:

PLACE MONUMENT SYMBOL & LOCATION ON ABOVE INCEX

CORNER MONUMENT

O WITHESS MONUMENT

(a)

BEARINGS ARE BASED ON:

PLANNING & ZONING COMMITTEE ADOPTED THE ABOVE FORM ON 12/2/1992 WI ADMINISTRATIVE CODE A-E 7.08 REQUIREMENT

SHEET \angle OF \angle

CORNER CODE

- Describe any record evidence, monument evidence, occupational evidence, testimonial evidence or any other material evidence you
- considered, and whether the monument was found or placed.

 1836 LYONS SET POST CORNER TO SECTIONS 29,30,31,&32 & MADE MOUND OF EARTH & SOD.
- 1859 HOBART VOL 1 PG 106&107 2638.68 TO S 1/4 COR SEC 30 & NO-40W 2641.32 TO E 1/4 COR SEC 30.VAR 5-30. 1859 HOBART VOL 1 PG 108 APPLE 1 1/2 N37 1/2E 255, SOUTH PILE MIDDLE
- BEND R.R. BRIDGE 10 N 28 1/2W 327, N89-25W 2659.80 TO S 1/4 COR SEC 29,N0-40W 2641.32 TO E 1/4 COR SEC 30.
- 1859 HOBART VOL 1 PG 121 NO-42W 2637.36 TO E 1/4 COR SEC 30,N89-58W 2638.68 TO S 1/4 COR SEC 30, BR OAK 10 N 30E 268, & CRAB APPLE 2 N61 1/2W 51.
- 18?? VOL 6 PG 331 TOWNSHIP ROAD RECORDS. CENTER OF ROAD AT CORNER.
 1979 BARNES VOL 6 PG 14 2647.05 TO N 1/4 COR SEC 31,2653.72 TO E 1/4 COR SEC 31, ANGLE OF 91-13-47 FROM E 1/4 COR SEC 31 TO N 1/4 COR SEC 31.

FOUND CAST IRON MONUMENT & PLACED CARSONITE POST. 2646.92 (REC 2647.05) TO N 1/4 COR SEC 31,2653.75 (REC 2653.72) TO E 1/4 COR SEC 31, ANGLE OF 91-13-38 (REC 91-13-47) FROM E 1/4 COR SEC 31 TO N 1/4 COR SEC

- Was the corner restored through acceptance of (1) an obliterated C) evidence location, or, (2) a found perpetuated location? ACCEPTED FOUND PERPETUATED LOCATION
- D) Describe any material discrepancy between the location of the corner as restored or reestablished and the location of that corner as previously restored or reestablished by distance and direction. Show the discrepancy on the plan view drawing under (a), above. Show the distances between the corner as previously restored or reestablished and (1) the corner as restored or reestablished, and (2) to at least 4 of the witness monuments shown on the drawing in (a), above.
- Was the corner reestablished through lost corner proportionate methods? If so, show the method, including the directions and distances to other public land survey corners used as evidence or used for proportioning the corner location.

I, Donald Barnes, hereby certify that the corner points as identified by the corner code index were, in a field survey on, 1994, established, re-established, monumented, re-monumented, recovered or restored as expressed below and in conformance with the regulations and rules as required in the current manual of survey instructions of the United States Department of Interior, Bureau of Land Management.

COUNTY SURVEYOR FILING DATA


Date of computer entry____

Date microfilmed

Number of included sheets CORNER CODE

A-E 7.08 REQUIREMENT

EMBOSS LAND SURVEYOR SEAL

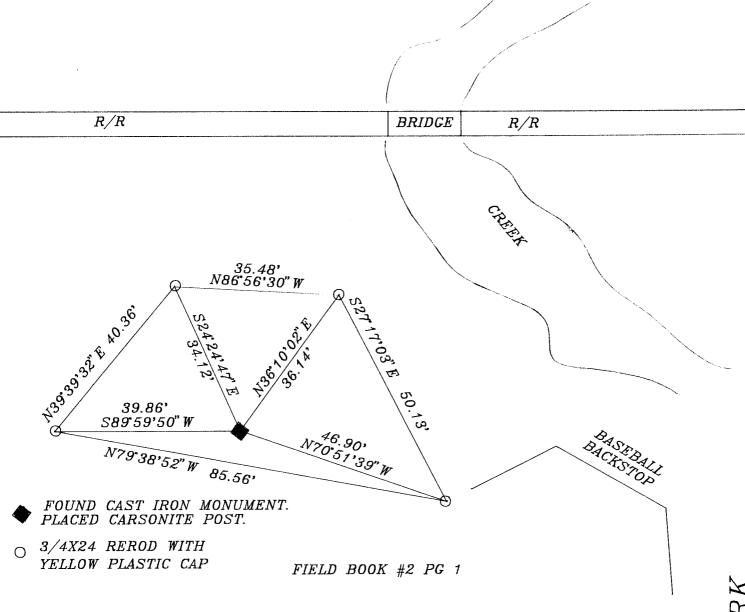

BASEBALL DIAMOND

Parale Basses 7/11/95

V5