


PUBLIC LAND SURVEY MONUMENT RECORD

For Public Land Survey Corners in the
 T. 1 N., R. 13 E
CORNER CODE INDEX

| | | | | | | | | | | | | | | | | | | | | | | | | |
|---|---|---|---|---|---|---|---|---|----|----|----|----|----|----|----|----|----|----|----|----|----|----|----|----|
| 1 | 2 | 3 | 4 | 5 | 6 | 7 | 8 | 9 | 10 | 11 | 12 | 13 | 14 | 15 | 16 | 17 | 18 | 19 | 20 | 21 | 22 | 23 | 24 | 25 |
| A | | | | | | | | | | | | | | | | | | | | | | | | |
| B | 6 | | | | | | | | | | | | | | | | | | | | | | | |
| C | | 5 | | | | | | | | | | | | | | | | | | | | | | |
| D | | | 4 | | | | | | | | | | | | | | | | | | | | | |
| E | | | | 3 | | | | | | | | | | | | | | | | | | | | |
| F | | | | | 2 | | | | | | | | | | | | | | | | | | | |
| G | 7 | | | | | | | | | | | | | | | | | | | | | | | |
| H | | 6 | | | | | | | | | | | | | | | | | | | | | | |
| I | | | 5 | | | | | | | | | | | | | | | | | | | | | |
| J | | | | 4 | | | | | | | | | | | | | | | | | | | | |
| K | | | | | 3 | | | | | | | | | | | | | | | | | | | |
| L | 8 | | | | | | | | | | | | | | | | | | | | | | | |
| M | | 7 | | | | | | | | | | | | | | | | | | | | | | |
| N | | | 6 | | | | | | | | | | | | | | | | | | | | | |
| O | | | | 5 | | | | | | | | | | | | | | | | | | | | |
| P | | | | | 4 | | | | | | | | | | | | | | | | | | | |
| Q | 9 | | | | | | | | | | | | | | | | | | | | | | | |
| R | | 8 | | | | | | | | | | | | | | | | | | | | | | |
| S | | | 7 | | | | | | | | | | | | | | | | | | | | | |
| T | | | | 6 | | | | | | | | | | | | | | | | | | | | |
| U | | | | | 5 | | | | | | | | | | | | | | | | | | | |
| V | | | | | | 4 | | | | | | | | | | | | | | | | | | |
| W | | | | | | | 3 | | | | | | | | | | | | | | | | | |
| X | | | | | | | | 2 | | | | | | | | | | | | | | | | |
| Y | | | | | | | | | 1 | | | | | | | | | | | | | | | |
| Z | | | | | | | | | | | | | | | | | | | | | | | | |

PLACE MONUMENT SYMBOL (●) AT PROPER LOCATION ON ABOVE INDEX

EXAMPLE

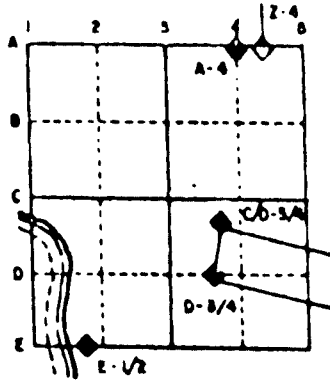

TURTLE TWP
 ROCK COUNTY WI

IF AVAILABLE
 STATE PLANE COORDINATES

North (Y) 232,872.77 Elev. (Z) _____
 East (X) 514,740.28 Zone _____
 Hor. Datum COUNTY Vert. Datum _____

◆ CORNER MONUMENT
 Fd C.1

○ WITNESS MONUMENT

Fd TIES IN ~~W~~ Z15 LA PRAIRIE TWP

BEARINGS ARE BASED ON:

SHEET ___ OF ___

CORNER CODE: A15

(B) Describe any record evidence, monument evidence, occupational evidence, testimonial evidence or any other material evidence you considered, and whether the monument was found or placed.

1861 RUGER VOL 1 PG 152 SET LIMESTONE 14X8X5 2667.06 TO NW COR SEC 3 & 2667.06 TO NE COR SEC 3.

1939 SUNNY VOL 3 PG 451 CORNER IN ROAD DITCH. FOUND NOTHING. CALLS FOR THE CORNER TO BE 102.6' WEST OF THE S 1/4 COR SEC 34.

1985 BARNES Z15 FOUND CI MON. 9 NORTH OF THE NORTH PAVEMENT EDGE & 102.60 WEST OF THE S 1/4 COR SEC 34.

FD CI MON & TIES. N88-30-26W 2672.76 TO NW COR SEC 3 & S88-32-55E 2677.37 TO NE COR SEC 3. MONUMENT IS 0.96' SOUTH OF A LINE BETWEEN THE NW & NE CORNERS OF SEC 3.

C) Was the corner restored through acceptance of (1) an obliterated evidence location, or, (2) a found perpetuated location?
ACCEPTED FOUND CORNER.

D) Describe any material discrepancy between the location of the corner as restored or reestablished and the location of that corner as previously restored or reestablished by distance and direction. Show the discrepancy on the plan view drawing under (a), above. Show the distances between the corner as previously restored or reestablished and (1) the corner as restored or reestablished, and (2) to at least 4 of the witness monuments shown on the drawing in (a), above.

(E) Was the corner reestablished through lost corner proportionate methods? If so, show the method, including the directions and distances to other public land survey corners used as evidence or used for proportioning the corner location.
NO

I, Donald Barnes, hereby certify that the corner points as identified by the corner code index were, in a field survey on, 1994, established, re-established, monumented, re-monumented, recovered or restored as expressed below and in conformance with the regulations and rules as required in the current manual of survey instructions of the United States Department of Interior, Bureau of Land Management.

seal

Donald Barnes
7/12/95

COUNTY SURVEYOR FILING DATA

Date of computer entry _____

Date microfilmed _____

Number of included sheets _____
CORNER CODE

EMBOSS LAND SURVEYOR SEAL

A-E 7.08 REQUIREMENT

A15