

PUBLIC LAND SURVEY MONUMENT RECORD

For Public Land Survey Corners in the


T. 1 N., R. 13 E

CORNER CODE INDEX

	1	2	3	4	5	6	7	8	9	10	11	12	13	14	15	16	17	18	19	20	21	22	23	24	25
A																									
B																									
C																									
D																									
E																									
F																									
G																									
H																									
I																									
J																									
K																									
L																									
M																									
N																									
O																									
P																									
Q																									
R																									
S																									
T																									
U																									
V																									
W																									
X																									
Y																									

PLACE MONUMENT SYMBOL (●) AT PROPER LOCATION ON ABOVE INDEX

EXAMPLE

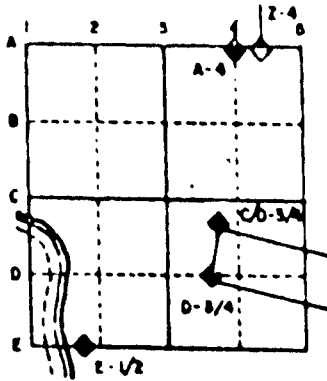

TURTLE TWP  
ROCK COUNTY WI

IF AVAILABLE  
STATE PLANE COORDINATES

North (Y) 227,481.79 Elev. (Z) \_\_\_\_\_  
East (X) 501,429.90 Zone \_\_\_\_\_  
Hor. Datum COUNTY Vert. Datum \_\_\_\_\_

◆ CORNER MONUMENT

○ WITNESS MONUMENT

*Fd C.1*

*Fd TIES IN VOL 4 PG 199*

BEARINGS ARE BASED ON:

SHEET \_\_\_\_\_ OF \_\_\_\_\_

*E5*

CORNER CODE:

(B) Describe any record evidence, monument evidence, occupational evidence, testimonial evidence or any other material evidence you considered, and whether the monument was found or placed.

- 1836 LYON SET POST CORNER TO SECTIONS 5,6,7,&8 MADE MOUND OF EARTH & SOD. CALLS FOR 2646.93 TO S 1/4 COR SEC 5 & 2640 TO S 1/4 COR SEC 6.
- 1854 Mc VEAN VOL 1 PG 24 CALLS FOR 5293.86 TO NE COR SEC 8.
- 1865 LOCKE VOL 1 PG 235 FOUND STAKE IN MOUND. CALLS FOR 2657.16 TO S 1/4 COR SEC 6
- 1882 HOLMES VOL 2 PG 357 FOUND OLD CEDAR STAKE ABOUT 2' SOUTH OF FENCE. CALLS FOR 2637.36 E 1/4 COR SEC 6 & 2658.15 TO S 1/4 COR SEC 6.
- 1970 BATTERMAN VOL 4 PG 479. SET C.I. & REFERENCED SAME. DID NOT STATE HOW HE ESTABLISHED THE LOCATION.

FOUND CAST IRON MONUMENT & TIES IN VOL 4 PG 479.

C) Was the corner restored through acceptance of (1) an obliterated evidence location, or, (2) a found perpetuated location?  
ACCEPTED FOUND PERPETUATED LOCATION.

D) Describe any material discrepancy between the location of the corner as restored or reestablished and the location of that corner as previously restored or reestablished by distance and direction. Show the discrepancy on the plan view drawing under (a), above. Show the distances between the corner as previously restored or reestablished and (1) the corner as restored or reestablished, and (2) to at least 4 of the witness monuments shown on the drawing in (a), above.

(E) Was the corner reestablished through lost corner proportionate methods? If so, show the method, including the directions and distances to other public land survey corners used as evidence or used for proportioning the corner location.  
NO

I, Donald Barnes, hereby certify that the corner points as identified by the corner code index were, in a field survey on, 1994, established, re-established, monumented, re-monumented, recovered or restored as expressed below and in conformance with the regulations and rules as required in the current manual of survey instructions of the United States Department of Interior, Bureau of Land Management.

Seal  
*Donald Barnes*  
7/12/95

COUNTY SURVEYOR FILING DATA  
Date of computer entry \_\_\_\_\_  
Date microfilmed \_\_\_\_\_  
Number of included sheets \_\_\_\_\_  
CORNER CODE