
## U.S.

## SURVE TUBLIC MONUMENT RECORD

For Public Land Survey Corners in the T. L. N., R. 13 E

CORNER CODE INDEX

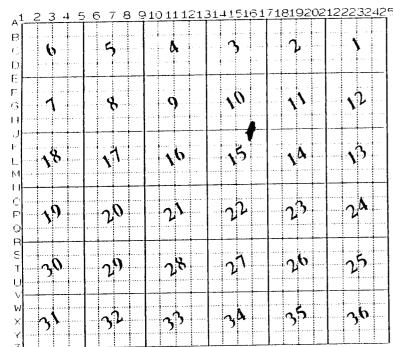

TURTLE		T	WI
ROCK	COUNTY	WI	

TE AVAILABLE ROCK COUNTY COORDITIATES PERFERRED

North 221,932,12 Elev.

East 5/6,0/8,60

Hor. Datum COUNTY Vert. Datum \_\_\_\_\_

TRAVERSE (X) GPS (X) \_\_\_\_ BASED ON THE FOLLOWING CONTROL:

PLACE MONUMENT SYMBOL & LOCATION ON ABOVE INCEX AT PROPER

OCORNER MONUMENT

Fd MON BOX

O WITHESS MONUMENT

BEANINGS AND

(a)

FIELD BOOK PAGE #

SHOW A PLAN VIEW DRAWTHS DEPICTING THE CORRER MONDERH AND SUPPORTIONING PHYSICAL FEATURES, INCLUDING THE EXCAVATION AREA AND DEPTH. THE CORRER MONDERH SHALL HAVE SHOW A PLAN VIEW DRAWTHS DEPTH THE OFFICE PREMARIT AT THE ORIGINAL POINT. THE FOLLOWING CHARACTERISTICS: 1) HAVE A LEAST TWO PREDETERMINED BREAK-COFF POINTS. 21 JE BROKERL LEAVE A PERHAMENTLY MACRETIZED REMAINT AT THE ORIGINAL POINT. THE CARREST ESTABLES A LEAST TWO PROPERTY OF THE SHAPE OF THE STORY OF THE STORY OF THE SHAPE OF THE STORY OF THE SHAPE OF THE SHAPE OF THE MARPHOLEPHINE CARRESTICS AND THE CORREST IS INCLUDED BY AN INFROVENENT GRAPHOLEPHIED CARRESTICS AND DRABLES INSTITUTE MONDER! MAY BE USED IT AREAS MERE CROWN OF THE SHAPE OF THE CORREST AND THE CORREST SHALL BE MADE OF CONCRETE, HATURAL DRABLES HOUSENED ON THE STORY OF THE SHAPE OF THE SHAPE OF THE STORY OF THE SHAPE OF

PLAINING & ZONING COMMITTEE ADOPTED THE ABOVE FORM ON 12/2/1982 WI ADMINISTRATIVE CODE A-E 7.08 DEDUTREMENT

SHEET \_\_\_\_OF \_\_

TU876 S 1/16TH SE 1/4 SEC 10

- (B) Describe any record evidence, monument evidence, occupational evidence, testimonial evidence or any other material evidence you considered, and whether the monument was found or placed.
  FOUND 1" PIPE IN MON. BOX 3.5 EAST OF CENTER OF PAVEMENT.
- C) Was the corner restored through acceptance of (1) an obliterated evidence location, or, (2) a found perpetuated location? ACCEPTED FOUND PERPETUATED LOCATION.
- D) Describe any material discrepancy between the location of the corner as restored or reestablished and the location of that corner as previously restored or reestablished by distance and direction. Show the discrepancy on the plan view drawing under (a), above. Show the distances between the corner as previously restored or reestablished and (1) the corner as restored or reestablished, and (2) to at least 4 of the witness monuments shown on the drawing in (a), above.
- (E) Was the corner reestablished through lost corner proportionate methods? If so, show the method, including the directions and distances to other public land survey corners used as evidence or used for proportioning the corner location.

I, Donald Barnes, hereby certify that the corner points as identified by the corner code index were, in a field survey on,1994, established, re-established, monumented, re-monumented, recovered or restored as expressed below and in conformance with the regulations and rules as required in the current manual of survey instructions of the United States Department of Interior, Bureau of Land Management.

county surveyor filing DATA

seal

Date of computer entry

Date microfilmed

Number of included sheets

CORNER CODE

EMBOSS LAND SURVEYOR SEAL A-E 7.08 REQUIREMENT