
U.S.

"UBLIC MONUMENT

SURVEY RECORD

For Public Land Survey Corners in the T. / N., R. /3 E

CORNER CODE INDEX

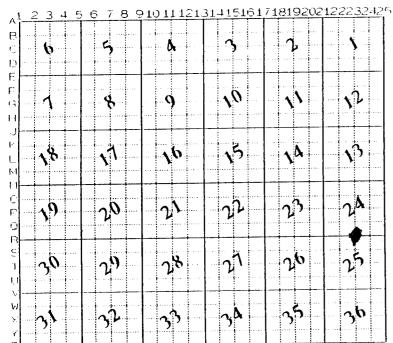

TURTLE ROCK COUNTY WI

IF AVAILABLE ROCK COUNTY COORDITIATES PERFERRED

Horth 211,048.92 Elev.

East 525, 275.50

Hor. Datum **COUNT**Y Vert. Datum ____

TRAVERSE (X) X GPS (X) ____ BASED ON THE FOLLOWING CONTROL:

PLACE MONUMENT SYMBOL \$\int \text{LOCATION ON ABOVE INDEX}

(a)

BEARINGS ARE BASED ON:

CORNER MONUMENT Fd ALUM MON

O WITHESS MONUMENT

Fd TIES IN VOLS Pg 220

FIELD BOOK PAGE #

SHOW A PLAN VIEW DRAWLING DEPICTING THE COTHER MORDMENT AND SUPROLIDING PHYSICAL FEATURES, INCLUDING THE EXCAVATION AREA AND DEPTH. THE CORNER MORDMENT AND SUPROLIDING PHYSICAL FEATURES, INCLUDING THE EXCAVATION AREA AND DEPTH. THE CORNER MORDMENT AT THE ORIGINAL POINT.

3) HIST DE EXTERDABLE. 4) THE CAR IS INSCRIPED TOOK COUNTY SURVEY HOUSEBUT - FEMALLY FOR DISTURBING MARKET. 5) OR AN EXISTING OUT LIVESTORE, AN INVINITION DIFF L 1/2"V

3) HIST DE EXTERDABLE. 4) THE CAR IS INSCRIPED TOOK COUNTY SURVEY HOUSEBUT - FEMALLY FOR DISTURBING MARKET. 5) OR AN EXISTING OUT LIVESTORE, AND HER OF COUNTY WHEN IN HIM OUT FOOD OF THE SURVEY HOUSEBUT IS OCCUPIED BY AN INFROVEMENT BIRAPPLEBUTION OF THE SURVEY HOUSEBUT HE CORNER IS DOCUPIED BY AN INFROVEMENT BIRAPPLEBUTION OF THE SURVEY HOUSEBUT AND THE CORNER SHALL BE REFERRED WITH AT LEAST 4 OURBARE WITHESS MONDREHIS SHALL, BE HATE OF CONSETTE HATTAIN OUR FOR OTHER SHALL BE REFERRED WITH AT LEAST 4 OURBARE WITHESS MONDREHIS SHALL, BE HATE OF CONSETTE HATTAIN OF THE CORNER AND THE SURVEY HATTAIN OUR FOR THE HATTAIN OUR FOOD OF CONSETTE HATTAIN OUR FOR THE FERRED BY HE CORNER SHALL BE HATE OF CONSETTE HATTAIN OUR FOR THE FERRED BY HATTAIN OUR FOOD OF CONSETTE HATTAIN OUR FOR THE SURVEY HATTAIN OUR FOOD OF CONSETTE HATTAIN OUR FOOD OUR F

ELAPHING & ZONIEM COMMITTEE ADOPTED THE ABOVE FORM ON 12/2/1992 WI ADMINISTRATIVE CODE A-E 7.08 REQUIREMENT

CORNER CODE

RZ3

SHEET ____OF ____

- Describe any record evidence, monument evidence, occupational evidence, testimonial evidence or any other material evidence you considered, and whether the monument was found or placed.

 1867 LOCKE VOL 1 PG 283 FOUND STUMP OF E BT & REMAINS OF W BT & OLD
- STAKE SET BR OAK STAKE & SURROUNDED BY HARDHEADS. 2645.28 TO
- CENTER OF SEC 24 & 5290.56 TO N 1/4 COR SEC 24.

 1869 LEE VOL 1 PG 349 FOUND STAKE SURROUNDED BY 4 HH.

 COR SEC 25,2657.82 VAR 4-42 TO NE COR SEC 25. 2658.48 TO NW
- 1869 LEE VOL 1 PG 350 SEE SEC 25. 2646.76 TO CENTER OF SEC 24.
- 1976 BARNES VOL 5 PG 220 DUG LARGE HOLE 10' WIDE & 4' DEEP ACROSS THE ROAD & FOUND NOTHING. SET CORNER PROPORTIONATE MEASUREMENT & ON LINE WITH SE & SW CORNERS OF SEC 24. REFERENCED SAME. 2659.30 TO SW COR SEC 24,2658.63 TO SE COR SEC 24,2645.92 TO FENCE AT CENTER OF SEC 24. SET ALUM. MON.
- 1980 BARNES VOL 6 PG 78 CALLS FOR THE CORNER TO BE ON LINE WITH THE SE & SW CORNERS OF SEC 24.

FOUND ALUM MON & TIES IN VOL 5 PG 220.

- Was the corner restored through acceptance of (1) an obliterated evidence location, or, (2) a found perpetuated location? ACCEPTED FOUND PERPETUATED LOCATION.
- Describe any material discrepancy between the location of the corner as restored or reestablished and the location of that corner as previously restored or reestablished by distance and direction. Show the discrepancy on the plan view drawing under (a), above. Show the distances between the corner as previously restored or reestablished and (1) the corner as restored or reestablished, and (2) to at least 4 of the witness monuments shown on the drawing in (a), above.
- (E) Was the corner reestablished through lost corner proportionate methods? If so, show the method, including the directions and distances to other public land survey corners used as evidence or used for proportioning the corner location.

I, Donald Barnes, hereby certify that the corner points as identified by the corner code index were, in a field survey on, 1994, established, re-established, monumented, re-monumented, recovered or restored as expressed below and in conformance with the regulations and rules as required in the current manual of survey instructions of the United States Department of Interior, Bureau of Land Management.

COUNTY SURVEYOR FILING DATA Seal Downes
7/18/95 Date of computer entry____ Date microfilmed Number of included sheets

EMBOSS LAND SURVEYOR SEAL A-E 7.08 REQUIREMENT

CORNER CODE