
U.S.

SURVEY "UBLIC MONUMENT RECORD

For Public Land Survey Corners in the T/_N, R. 13_E

CORNER CODE INDEX

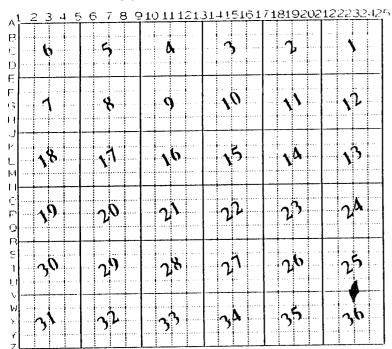

TURTLE ROCK COUNTY WI

IF AVAILABLE ROCK COUNTY COORDINATES PERFERRED

North 205,745, 47 Elev.

East 525, 273.70

Hor. Datum COUNTY Vert. Datum

TRAVERSE (X) X GPS (X) BASED OF THE FOLLOWING CONTROL:

PLACE MONUMENT SYMBOL & LOCATION ON ABOVE INDEX

OCORNER MONUMENT

O WITHESS MONUMENT

(a)

BEARINGS ARE BASED ON:

PLAINING & ZOULING COMMITTEE ADOPTED THE ABOVE FORM ON 12/2/1992 WI ADMINISTRATIVE CODE A-E 7.08 REQUIREMENT

CORNER CODE

V23

FIELD BOOK PAGE #

SHOW A PLAN VIEW DRAWING DEPICTING THE CORNER MORRISHT AND SURROUGHING DIVISION, FEATURES, INCLUDING THE EXCAVATION AREA AND DEPTH. THE CORNER MORRISHT AND SURROUGHING DIVISION, A DEPTH BONGEL LEAVE A PERMIEMILLY MAGNETIZED REMAINT AT THE ORIGINAL POINT.

11 HE FOLLOWING CHARGINGTON: 11 HAVE A LEAST THE ORIGINAL POINT.

21 HISTORY OF THE CAPTURE OF THE CAPTURE OF THE CORNER OF THE CAPTURE SHEET OF

- Describe any record evidence, monument evidence, occupational evidence, testimonial evidence or any other material evidence you considered, and whether the monument was found or placed.
- 1836 LYONS SET QUARTER SECTIONS 25&36. BUR OAK 14 S71E 16 & BUR OAK 13 N40W 52. CALLS FOR 2641.65 TO SE & SW CORNERS OF SEC 25.
- 1861 HOBART VOL 1 PG 157 2643.96 TO NW COR SEC 36,2656.5 CENTER SEC 36, & 5292.54 TO S 1/4 COR SEC 36. 1962 BATTERMAN VOL 4 PG 64 FOUND 2" PIPE & REFERENCED SAME.
- 1979 BARNES VOL 5 PG 533 CALLS FOR THE FOLLOWING MEASUREMENTS BY SCHROEDER 2656.60 TO NE COR SEC 36,2646.26 TO CENTER SEC 36,5281.5 TO S 1/4 COR SEC 36, ANGLE OF 87-54-42 FROM NE COR SEC 36 TO CENTER SEC 36.
- 1980 BARNES VOL 6 PG 78 FOUND PK THAT AGREES WITH TIES. 2655.41 TO SW COR SEC 25.

FOUND PK AND TIES.

- Was the corner restored through acceptance of (1) an obliterated evidence location, or, (2) a found perpetuated location? ACCEPTED FOUND PERPETUATED LOCATION
- Describe any material discrepancy between the location of the corner as restored or reestablished and the location of that corner as previously restored or reestablished by distance and direction. Show the discrepancy on the plan view drawing under (a), above. Show the distances between the corner as previously restored or reestablished and (1) the corner as restored or reestablished, and (2) to at least 4 of the witness monuments shown on the drawing in (a), above.
- Was the corner reestablished through lost corner proportionate methods? If so, show the method, including the directions and distances to other public land survey corners used as evidence or used for proportioning the corner location. NO

I, Donald Barnes, hereby certify that the corner points as identified by the corner code index were, in a field survey on, 1994, established, re-established, monumented, re-monumented, recovered or restored as expressed below and in conformance with the regulations and rules as required in the current manual of survey instructions of the United States Department of Interior, Bureau of Land Management.

Donal Laines

EMBOSS LAND SURVEYOR SEAL A-E 7.08 REQUIREMENT

COUNTY SURVEYOR FILING DATA Date of computer entry____ Date microfilmed

Number of included sheets CORNER CODE