

**U.S. PUBLIC LAND SURVEY MONUMENT RECORD**


For Public Land Survey Corners in the  
T. 1 N., R. 13 E.

**CORNER CODE INDEX**

	1	2	3	4	5	6	7	8	9	10	11	12	13	14	15	16	17	18	19	20	21	22	23	24	25
A																									
B																									
C	6																								
D		5																							
E			4																						
F				3																					
G					2																				
H																									
I																									
J	7																								
K		8																							
L			9																						
M				10																					
N					11																				
O						12																			
P							13																		
Q								14																	
R									15																
S										16															
T											17														
U												18													
V													19												
W														20											
X															21										
Y																22									
Z																	23								
																		24							
																			25						
																				26					
																					27				
																						28			
																							29		
																								30	
																									31
																									32
																									33
																									34
																									35
																									36

PLACE MONUMENT SYMBOL (◆) AT PROPER LOCATION ON ABOVE INDEX

**EXAMPLE**

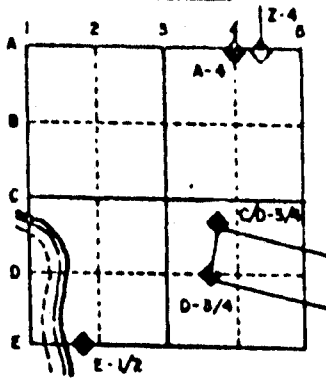

TURTLE TWP  
ROCK COUNTY WI


IF AVAILABLE  
STATE PLANE COORDINATES

North (Y) 200,463.56      Elevation (Z) \_\_\_\_\_  
East (X) 525,277.11      Zone \_\_\_\_\_  
Hor. Datum COUNTY      Vert. Datum \_\_\_\_\_

◆ CORNER MONUMENT

○ WITNESS MONUMENT

BEARINGS ARE BASED ON: ASSUMED

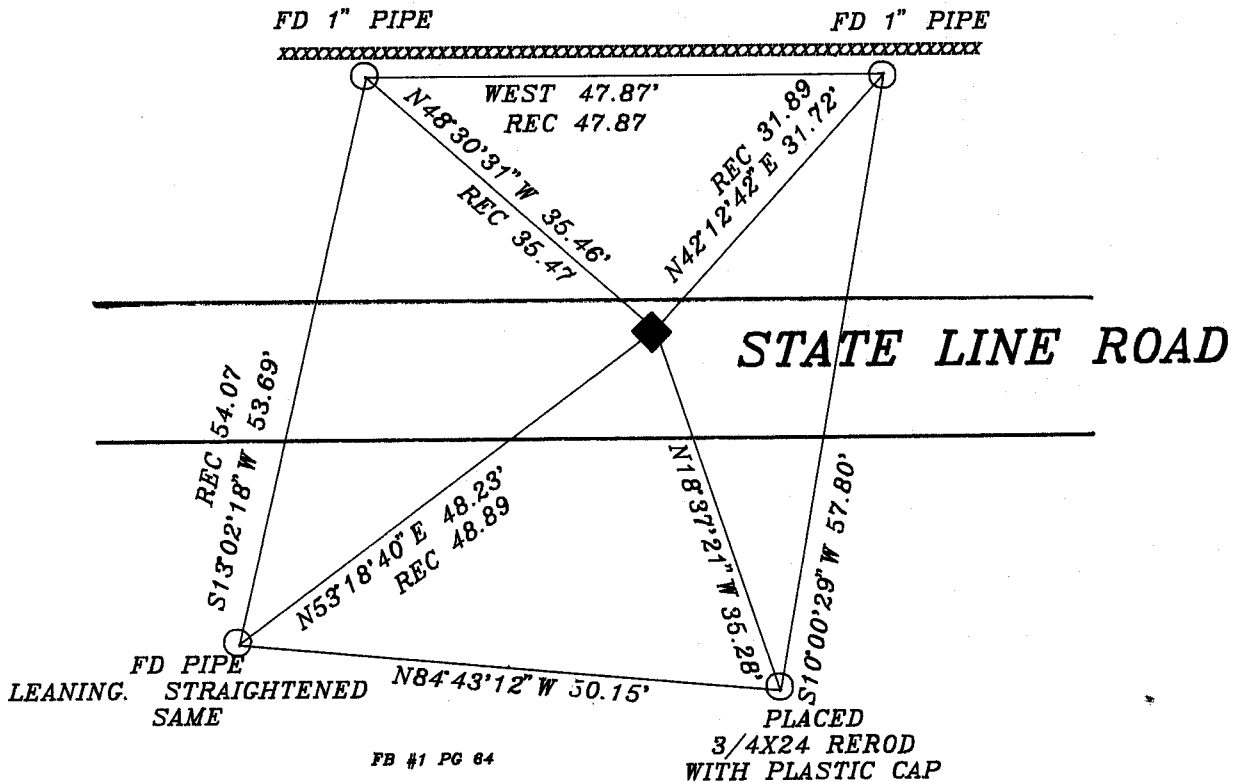

FB #1 PG 84

PLACED  
3/4X24 REROD  
WITH PLASTIC CAP

**MICROFILMED**

SHEET     OF    

CORNER CODE: 223

(B) Describe any record evidence, monument evidence, occupational evidence, testimonial evidence or any other material evidence you considered, and whether the monument was found or placed.

1833 LYONS ORIGINAL SURVEYOR. SET POST FOR 1/4 SECTION CORNER BUR OAK 16 N46E 109.56;BLACK OAK 16 N23W 140.58.

1861 HOBART VOL 1 PG 157 SET HH. CALLS FOR 2636.04 TO CENTER OF SECTION 36 AND 1323.30 TO S 1/16TH CORNER OF SE 1/4 OF SECTION 36 AND 2646.60 TO THE SE CORNER OF SECTION 36.

1978 BARNES VOL 5 PG 415 DUG 4' DEEP AND FOUND NOTHING. PLACED ALUMINUM MONUMENT ON LINE WITH SE AND S 1/16TH CORNER OF SEC 1/4 OF SECTION 36 AT SINGLE PROPORTIONATE DISTANCE. CALLS FOR 1323.44 TO S 1/16TH CORNER OF SE 1/4 OF SECTION 36.

1978 BARNES VOL 5 PG 456 CALLS FOR 2642.90 TO SW CORNER OF SECTION 36.

1979 SCHROEDER VOL 5 PG 533 CALLS FOR 2635.24 TO CENTER OF SECTION 36.

FOUND ALUMINUM MONUMENT.


C) Was the corner restored through acceptance of (1) an obliterated evidence location, or, (2) a found perpetuated location?

ACCEPTED FOUND MONUMENT.

D) Describe any material discrepancy between the location of the corner as restored or reestablished and the location of that corner as previously restored or reestablished by distance and direction. Show the discrepancy on the plan view drawing under (a), above. Show the distances between the corner as previously restored or reestablished and (1) the corner as restored or reestablished, and (2) to at least 4 of the witness monuments shown on the drawing in (a), above.

(E) Was the corner reestablished through lost corner proportionate methods? If so, show the method, including the directions and distances to other public land survey corners used as evidence or used for proportioning the corner location.

I, Donald Barnes, hereby certify that the corner points as identified by the corner code index were, in a field survey on, November 20, 1991, established, re-established, monumented, re-monumented, recovered or restored as expressed below and in conformance with the regulations and rules as required in the current manual of survey instructions of the United States Department of Interior, Bureau of Land Management.

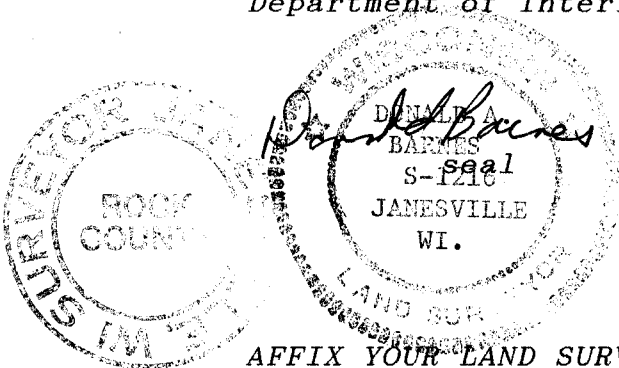

AFFIX YOUR LAND SURVEYOR SEAL

COUNTY SURVEYOR FILING DATA

Date of computer entry \_\_\_\_\_

Date microfilmed \_\_\_\_\_

Number of included sheets \_\_\_\_\_  
CORNER CODE