

U.S. PUBLIC LAND SURVEY MONUMENT RECORD

For Public Land Survey Corners in:

WI ADMINISTRATIVE CODE A-E 7.08 REQUIREMENT

T. 1N., R. 13E

CORNER CODE INDEX

A	1	2	3	4	5	6	7	8	9	10	11	12	13	14	15	16	17	18	19	20	21	22	23	24	25
B																									
C	6					5				4				3				2						1	
D																									
E																									
F																									
G	7					8				9				10				11						12	
H																									
I																									
J																									
K																									
L	18									17				16				15							14
M																									
N																									
O																									
P	19									20				21				22							24
Q																									
R																									
S																									
T	30									29				28				27							25
U																									
V																									
W																									
X	31									32				33				34							36
Y																									
Z																									

TURTLE TWP

ROCK COUNTY WI

IF AVAILABLE
ROCK COUNTY COORDINATES PREFERRED

North _____ Elev. _____

East _____

Hor. Datum _____ Vert. Datum _____

LATITUDE _____ ELLIPS. HT. _____

LONGITUDE _____

GPS (X) _____ TRAVERSE (X) _____

BASED ON THE FOLLOWING CONTROL:

PLACE MONUMENT SYMBOL AT PROPER LOCATION ON ABOVE INDEX

CORNER MONUMENT

WITNESS MONUMENT

(a)

BEARINGS ARE BASED ON:

FIELD BOOK _____ PAGE # _____

SHEET 1 OF 2

SHOW A PLAN VIEW DRAWING DEPICTING THE CORNER MONUMENT AND SURROUNDING PHYSICAL FEATURES, INCLUDING THE EXCAVATION AREA AND DEPTH.

PLANNING & ZONING COMMITTEE ADOPTED THE ABOVE FORM ON 12/2/1982

CORNER CODE JS(1)

TU543 SE 7

(B) Describe any record evidence, monument evidence, occupational evidence, testimonial evidence or any other material evidence you considered, and whether the monument was found or placed.

1929 BATTERMAN VOL 3 PG 176 FOUND GAS PIPE CALLS FOR 2663.1 TO E 1/4 & 2646.7 TO FENCE INTERSECTION AT S 1/4 CORNERS OF SECTION 7.

1929 BATTERMAN BK 16 PG 22 "GORNET'S SUB"- 2" PIPE. EASTERLY 254.43' TO A 1" PIPE WHICH IS 33.50 FROM A PIPE IN THE CENTER OF THE PAVEMENT. PIPE AT THE CENTER OF PAVEMENT IS ELEVATION 802.40. PLAT SHOWS A CONFLICT AT THE CORNER. CALLS FOR A PIPE 3.88' WEST & 0.35 NORTH OF THE SECTION LINE. ALSO CALLS FOR A PIPE 3.88' WEST OF A 2" PIPE AT THE SOUTH LINE OF THE SUBDIVISION.

1963 BATTERMAN BK 22 PG 7 "CLOVERDALE" FOUND EXISTING 1" PIPE. EASTERLY 247.09' IS A 1" PIPE WHICH IS 40.84' FROM THE CENTER OF THE PAVEMENT. 90-31-50 ANGLE AT THE SW FROM THE W 1/4 TO THE S 1/4 CORNER OF SECTION 8.

1995 BARNES J-5 FOUND 2" PIPE LEANING. DROVE PIPE DEEP. PLACED 3/8"X24" REROD INSIDE PIPE 15" DEEP WITH MAGNETS.

JOHN KREBS REPORTED THAT THEY PLACED A 3/4X4' PIN 1.6' DEEP WITH THE ABOVE MAGNETS AT THE LOCATION OF THE TIES AS SHOWN IN 1995, J-5. IN THE 1995 RECORD, I INCORRECTLY STATED THAT I ACCEPTED THE FOUND 2" PIPE. INSTEAD I USED RECORD DISTANCES AND DID NOT INSTALL A MONUMENT.

C) Was the corner restored through acceptance of (1) an obliterated evidence location, or, (2) a found perpetuated location?
ACCEPTED OBLITERATED EVIDENCE LOCATION.

D) Describe any material discrepancy between the location of the corner as restored or reestablished and the location of that corner as previously restored or reestablished by distance and direction. Show the discrepancy on the plan view drawing under (a), above. Show the distances between the corner as previously restored or reestablished and (1) the corner as restored or reestablished, and (2) to at least 4 of the witness monuments shown on the drawing in (a), above.

(E) Was the corner reestablished through lost corner proportionate methods? If so, show the method, including the directions and distances to other public land survey corners used as evidence or used for proportioning the corner location.
NO

I, Donald Barnes, hereby certify that the corner points as identified by the corner code index were, in a field survey on, _____, 1994, established, re-established, monumented, re-monumented, recovered or restored as expressed below and in conformance with the regulations and rules as required in the current manual of survey instructions of the United States Department of Interior, Bureau of Land Management.

Donald Barnes
seal
May 14 1997

COUNTY SURVEYOR FILING DATA


Date of computer entry _____

Date microfilmed _____

Number of included sheets _____
CORNER CODE

AFFIX YOUR LAND SURVEYOR SEAL

J5 (1)

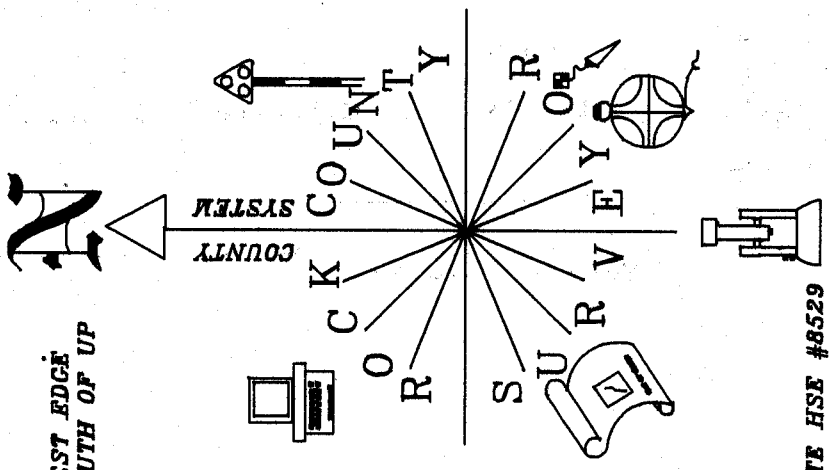

3/4X24 REROD
 10' WEST OF WEST EDGE
 PVMT, +/-50 SOUTH OF UP

N6-61-37E 507.87

CREEK RD
 CENTER OF PVMT
 FD BENT PIPE
 REC 33.50
 589-17-16E 33.45
 FD 2" PIPE
 REC 40.84
 589-41-07E 40.80
 FD 2" PIPE

537-20-07E 690.01
 FARM FIELD

NO-14-01E 2663.18
 TO W 1/4 COR

REC 3.88
 S85-35-04E
 SE COR 4.03
 SEC 7

S89-29-13W 2652.73
 TO S 1/4 COR

S0-01-53W 2666.21
 TO W 1/4 COR
 S0-01-60W 1368.44

2.51
 FD PIPE
 FD PIPE

REC 247.09
 S89-22-49E 247.19
 REC 287.93
 REC 287.99
 S62-51-01E 320.50
 S62-49-14E 325.50

N10-30-03E 150.01
 FD PIN
 FD PIPE

S89-18-13E 2654.77
 TO S 1/4 COR

REC 99-53-10
 99-47-23-06

OPPOSITE HSE #8529

S8-COR-S8E 7-
 FD 2" PIPE LEANING.
 DROVE DEEP & PLACED
 3/2X24 REROD
 INSIDE PIPE.

3/4" X 4" PIN 1.6"
 DEEP WITH MAGNETS
 S6 COR SEC 7

8/19/99 DAB

PIPE IS 0.02'
 EAST OF LINE
 BETWEEN W 1/4 COR
 SEC 17 & NW
 COR SEC 17

Donald Barnes
 May 14, 1997

JS (1)