
## U.S.

## SURVEY ^ ND TUBLIC MONUMENT RECORD

For Public Land Survey Corners in the T. / N., R. 13 E

CORNER CODE INDEX

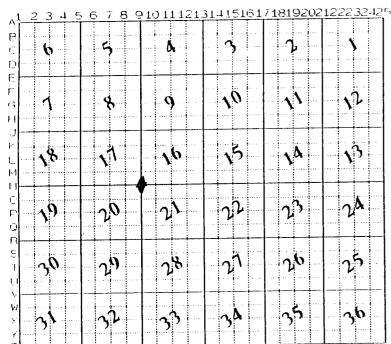

TURTLE ROCK COUNTY WE

IF AVAILABLE ROCK COUNTY COORDINATES PERFERRED

Morth 2/6,855.48 Elev.

East 506, 676,96

Hor. Datum COUNTY Vert. Datum

TRAVERSE (X) GPS (X) BASED ON THE FOLLOWING CONTROL:

PLACE MONUMENT SYMBOL & LOCATION ON ABOVE INDEX

(a)

BEARINGS ARE BASED ON:

CORMER MONUMENT Fd Poly MON

O WITHESS MONUMENT

FU TIES IN N9

FIELD BOOK PAGE #

SHOW A PLANT VIEW DRAWLING DEPICTING THE CORNER MORARMAT AND SUPROLIZIONS PHYSICAL FEATURES, INCLIDING THE EXCAVATION AREA AND DEPTH. THE CORNER MORARMAT SHALL HAVE SHOW A PLANT VIEW DRAWLING CHARGING CHARGING

ELABBING & ZONING COMMITTEE ADOPTED THE ABOVE FORM ON 12/2/1982 WI ADMINISTRATIVE CODE A-E 7:08 REQUIREMENT

SHEET \_\_\_OF \_\_\_

CORNER CODE

N9(1)

- Describe any record evidence, monument evidence, occupational evidence, testimonial evidence or any other material evidence you
- considered, and whether the monument was found or placed. 1911 KERCH VOL 3 PG 64 FOUND STAKE SET GAS PIPE. 2632.2 2632.2 TO N 1/4 COR SEC 20,2658.2 TO E 1/4 COR SEC 20,& 89-43-45 FROM E 1/4 COR TO N 1/4 COR SEC 20.
- 1986 BARNES N9 FOUND 2 1/2X3' PIPE LEANING & SURROUNDED BY 4 L.S. WHICH WERE ABOUT 1' DEEP. REPLACED PIPE WITH POLY MON. CARSONITE POST ON EAST FACE OF MONUMENT.
- 1995 BARNES VOL 6 PG 442 2631.93 TO N 1/4 COR SEC 20,2658.22 TO E 1/4 COR SEC 20, &89-44-42 FROM E 1/4 COR TO N 1/4 COR SEC 20.

FOUND POLY MON. & REFERENCE TIES.

- Was the corner restored through acceptance of (1) an obliterated evidence location, or, (2) a found perpetuated location? ACCEPTED FOUND PERPETUATED LOCATION.
- D) Describe any material discrepancy between the location of the corner as restored or reestablished and the location of that corner as previously restored or reestablished by distance and direction. Show the discrepancy on the plan view drawing under (a), above. Show the distances between the corner as previously restored or reestablished and (1) the corner as restored or reestablished, and (2) to at least 4 of the witness monuments shown on the drawing in (a), above.
- Was the corner reestablished through lost corner proportionate methods? If so, show the method, including the directions and distances to other public land survey corners used as evidence or used for proportioning the corner location.

I, Donald Barnes, hereby certify that the corner points as identified by the corner code index were, in a field survey on,1994, established, re-established, monumented, re-monumented, recovered or restored as expressed below and in conformance with the regulations and rules as required in the current manual of survey instructions of the United States Department of Interior, Bureau of Land Management.

COUNTY SURVEYOR FILING DATA

Date of computer entry

Date microfilmed \_

Number of included sheets

CORNER CODE

EMBOSS LAND SURVEYOR SEAL

A-E 7.08 REQUIREMENT