U.S.

(a)


BEARINGS ARE BASED ONE

## ^ ND "UBLIC MONUMENT

## SURVEY RECORD

For Public Land Survey Corners in the T. / N., R. /3 E

CORNER CODE INDEX

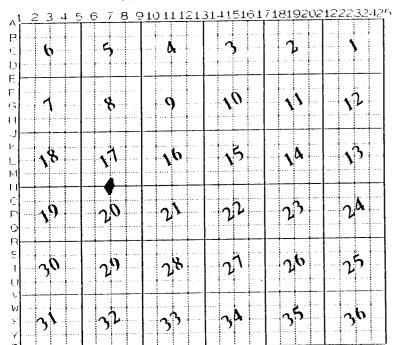

TURTLE ROCK COUNTY WI

IF AVAILABLE ROCK COUNTY COORDINATES PERFERRED

North 2/6, 869,73 Elev.

East 504, 045,09

Hor. Datum COUNTY Vert. Datum

TRAVERSE (X) X\_ GPS (X) \_\_\_\_ BASED ON THE FOLLOWING CONTROL:

PLACE MONUMENT SYMBOL • LOCATION ON ABOVE INDEX

CORNER MONUMENT

O WITHESS MONUMENT

FO DISK IN CONCRETE MON,

Fd TIES IN NO

FIELD BOOK PAGE #

SHOW A PLAN VIEW DRAWLING DEPICTING THE CORNER MORDERIN AND SUPROBLOING PHYSICAL FEATUPES, INCLUDING THE EXCAVATION AREA AND DEPTH. THE CREMEN MORDERIN SMALL HAVE THE FOLLOWING CHARPOLIERISTICS: 11 HAVE A LEAST TWO PREDETERMINED BREAK-OFF POINTS. 2) IF BROKET LEAVE A PERTAMENTLY MAGNETIZED PRIMINED AT THE CORDINAL POINT.

3) HIST OF EXTENDABLE. 4) THE CAR IS INSCRIPED THORK CREATY SURVEY MORDER OF THE CORNER IS OCCUPIED BY AN EXISTING OUT LINESTORE. AND HAVE YOUR FOUND OF THE SURVEY OF THE CORNER IS OCCUPIED BY AN EXISTING UNFORCEMENT GRAPHIC CARLELIO AND AS DISTRIBUTED THAT HAVE DEUGED IN AN EXISTING WEIGHT CONTROL OF THE SURVEY OF THE CORNER IS OCCUPIED BY AN EXISTING UNFORCEMENT BIANDLE PROBLEM OF CREATER HAVE BEEN AND THE WILLESS MONDERED SHALL BE HAVE OF CREATER HAVING STONE, DISTRIBUTED WITH AN OF USED CONTROL OF THE SURVEY OF THE MORD OF CREATER HAVING STONE, DISTRIBUTED CONTROL OF THE SURVEY OF THE MORD OF CREATER HAVING STONE, DISTRIBUTED CONTROL OF THE MORD OF CREATER HAVE AND THE MORD OF CREATER HAVING STONE, DISTRIBUTED CONTROL OF THE MORD OF CREATER HAVE AND THE MORD OF

PLAIRING & ZONING COMMITTEE ADOPTED THE ABOVE FORM ON 12/2/1992 WI ADMINISTRATIVE CODE A-E 7.08 REQUIREMENT

SHEET \_\_\_\_OF

- Describe any record evidence, monument evidence, occupational evidence, testimonial evidence or any other material evidence you
- considered, and whether the monument was found or placed.
  1911 KERCH VOL 3 PG 64 FOUND OLD STAKE NW BT & REMAINS OF SE BT STUMP. SET 2" GAS PIPE. CORNER IS 5.1' NORTH OF LINE BETWEEN CORNERS. 2632.2 TO NE COR SEC 20,2637.6 TO NW COR SEC 20,2658.85 TO CENTER SEC 20, ANGLE 89-43-45 E 1/4 COR TO N 1/4 COR SEC 20. 1971 VOL 3 PG 64. SET CONC. MON.
- 1986 BARNES VOL 6 PG 442 2631.93 TO NE COR SEC 20,2638.96 TO NW COR SEC 20,2658.75 TO CENTER OF SEC 20,ANGLE OF 89-44-42 AT NE COR SEC 20 FROM E 1/4 COR TO N 1/4 COR SEC 20, ANGLE OF 90-15-51 AT N 1/4 COR SEC 20 FROM NE TO CENTER OF SEC 20.
- 1987 BARNES N7 FOUND CONCRETE MONUMENT IN POOR CONDITION. MONUMENT ; IS 12" ABOVE THE GROUND. PLACED CARSONITE POST NEXT TO MONUMENT.

FOUND DISK IN CONCRETE MONUMENT & TIES FROM N7

- Was the corner restored through acceptance of (1) an obliterated evidence location, or, (2) a found perpetuated location? ACCEPTED FOUND PERPETUATED LOCATION.
- Describe any material discrepancy between the location of the corner as restored or reestablished and the location of that corner as previously restored or reestablished by distance and direction. Show the discrepancy on the plan view drawing under (a), above. Show the distances between the corner as previously restored or reestablished and (1) the corner as restored or reestablished, and (2) to at least 4 of the witness monuments shown on the drawing in (a), above.
- Was the corner reestablished through lost corner proportionate methods? If so, show the method, including the directions and distances to other public land survey corners used as evidence or used for proportioning the corner location. NO

I, Donald Barnes, hereby certify that the corner points as identified by the corner code index were, in a field survey on, 1994, established, re-established, monumented, re-monumented, recovered or restored as expressed below and in conformance with the regulations and rules as required in the current manual of survey instructions of the United States Department of Interior, Bureau of Land Management.

| COUNTY SURVEYOR FILING DATA |
|-----------------------------|
| Date of computer entry      |
| Date microfilmed            |
| Number of included sheets   |

EMBOSS LAND SURVEYOR SEAL

A-E 7.08 REQUIREMENT

CORNER CODE