## U.S.


## PUBLIC LAND SURVEY MONUMENT RECORD

For Public Land Survey Corners in:

WI ADMINISTRATIVE CODE A-E 7.08 REQUIREMENT

T. 3 N., R. //\_\_E

CORNER CODE INDEX

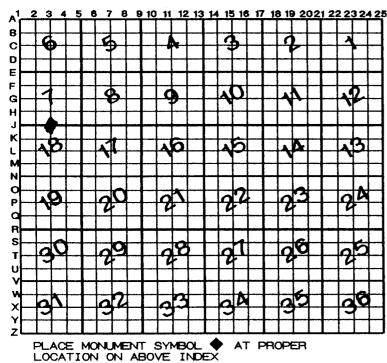

CENTER TWE

IF AVAILABLE ROCK COUNTY COORDINATES PERFERRED

North \_\_\_\_\_ Elev. \_\_\_\_

Fast

Hor. Datum \_\_\_\_\_ Vert. Datum \_\_\_\_

LATITUDE \_\_\_\_\_ELLIPS. HT.

LONGITUTE \_\_\_

GPS (X) \_\_ TRAVERSE (X) \_\_

BASED ON THE FOLLOWING CONTROL:

**♦**CORNER MONUMENT

O WITNESS MONUMENT

BEARINGS ARE BASED ON:

(a)

FIELD BOOK \_\_\_\_\_PAGE # \_\_\_\_\_ SHEET \_\_\_\_ OF \_\_\_\_ SHOW A PLAN VIEW DRAWING DEPICTING THE CORNER MONUMENT AND SURROUNDING PHYSICAL FEATURES, INCLUDING THE EXCAVATION AREA AND DEPTH.
PLANNING & ZONING COMMITTEE ADOPTED THE ABOVE FORM ON 12/2/1982

Describe any record evidence, monument evidence, occupational evidence, testimonial evidence or any other material evidence you considered, and whether the monument was found or placed. 1833 HARRISON ORIGINAL SURVEYOR.

WEST BETWEEN 7 & 18

LEAVE PRAIRIE & ENTER MARSH

2640 QUARTER SEC COR IN MARSH NO MOUND WATER DEEP.

LEAVE MARSH & ENTER ???

5056.92 WHITE OAK 12 5172.42 INT. WEST BOUNDARY 180.84' NORTH OF POST WHITE OAK 24 N71E 62.04'; HICKORY 12 S82W 34.32'

- 1863 LOCKE VOL 1 PG 181 SUBDIVIDED SEC 18. SET STAKE IN MARSH. 2653.2' TO CENTER OF SEC 18 & 2653.2 TO S 1/4 COR SEC 18. DID NOT STATE WHAT HE FOUND NOR HOW HE ESTABLISHED THE CORNER.
- 1876 RUGER VOL 2 PG 218 & MAP #707 DROVE CEDAR STAKE AT CORNER.  $2647.92\,^{\prime}$  VAR 6-24 TO NE COR SEC 18, 1323.96' TO A FOUND HH STONE THAT HE PUT A LARGE HH STONE ON TOP OF IT & SURROUNDED IT WITH SMALLER STONES AT THE N 1/16TH COR OF THE NE 1/4 OF SEC 18, 2562.12' VAR 6-18 TO NW CORNER OF SEC 18, AND 1335.18 TO THE N 1/16TH COR OF THE NW 1/4 OF SEC 18 WHERE HE DROVE STAKE & PUT FLINT STONE ON E & W SIDES. HIS USE OF VAR. INDICATES THAT THE CORNER IS NOT ON A STRAIGHT LINE BETWEEN THE NE AND NW CORNERS OF


CORNER WAS DESTROYED BY CONSTRUCTION OF IRRIGATION DITCH. DID NOT PLACE MONUMENT BECAUSE IT IN THE DITCH. THE COMPUTED N 1/16TH CORN OF THE NE 1/4 OF SEC 18 IS 1' NORTH OF THE E/W FENCE. DUG AT THE N THE COMPUTED N 1/16TH CORNER 1/16TH CORNER AND DID NOT FIND RUGER'S MONUMENT.

- Was the corner restored through acceptance of (1) an obliterated evidence location, or, (2) a found perpetuated location?
  RESTORED CORNER THROUGH ACCEPTANCE OF OBLITERATED EVIDENCE LOCATION. TO CONTROL THE N/S POSITION I PLACED THE CORNER ON LINE BETWEEN THE NE & NW CORNERS OF SEC 18 WHICH IS IN HARMONY WITH THE E/W FENCE AND PRORATED WITH RUGER'S 1876 DISTANCES.
- D) Describe any material discrepancy between the location of the corner as restored or reestablished and the location of that corner as previously restored or reestablished by distance and direction. Show the discrepancy on the plan view drawing under (a), above. Show the distances between the corner as previously restored or reestablished and (1) the corner as restored or reestablished, and (2) to at least 4 of the witness monuments shown on the drawing in (a), above.
- (E) Was the corner reestablished through lost corner proportionate methods? If so, show the method, including the directions and distances to other public land survey corners used as evidence or used for proportioning the corner location.
- I, Donald Barnes, hereby certify that the corner location as identified by the corner code index was determined by me under by direction and control and that this U.S. Public Land Survey Monument Record is correct and complete to the best of my knowledge and belief.

Donald Baines Oct 4 1996

Number of included sheets

emboss

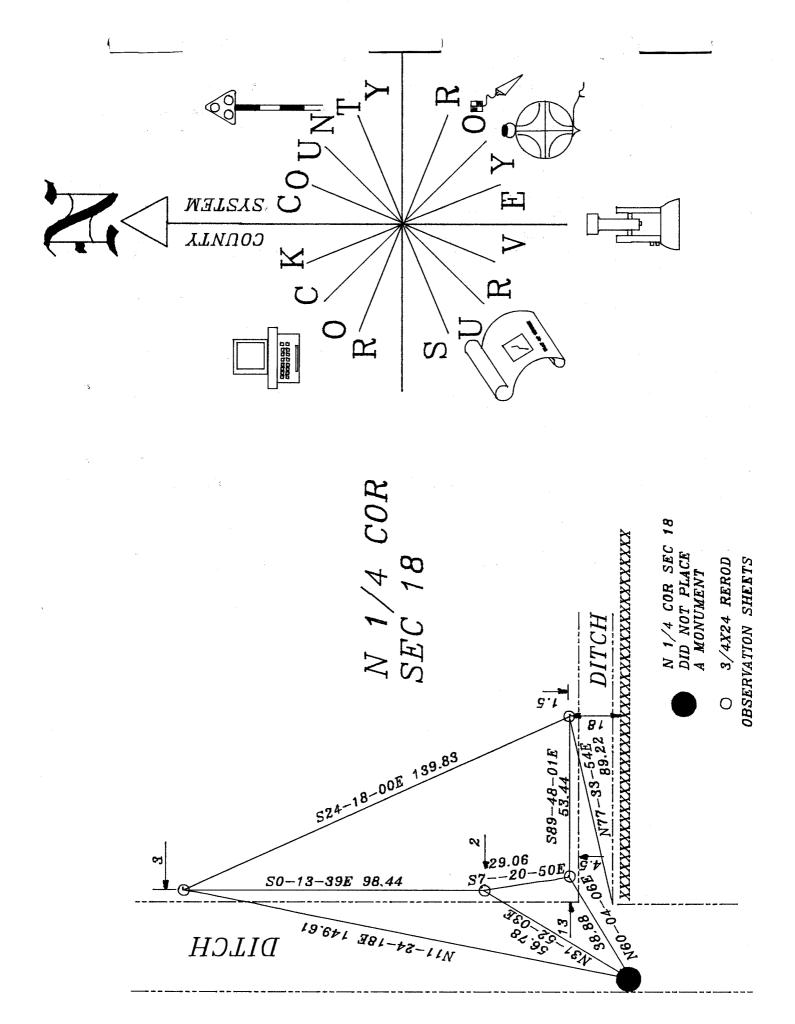

Romald Bounes Oct 3, 1996 XXXXXXXXXXXXXX

Darl Barres

