Black no

required


PUBLIC LAND SURVEY MONUMENT RECORD

For Public Land Survey Corners in:

WI ADMINISTRATIVE CODE A-E 7.08 REQUIREMENT

T. 3 N., R. //_E

CORNER CODE INDEX

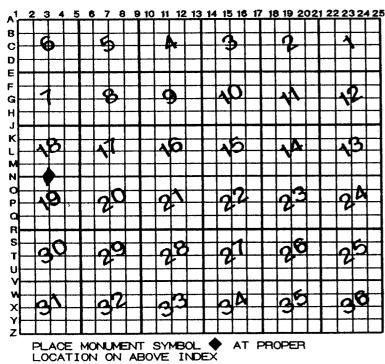

CENTER TWP
ROCK COUNTY WI

IF AVAILABLE ROCK COUNTY COORDINATES PERFERRED

North ______ Elev. _____

East _____

Hor. Datum _____ Vert. Datum _____

LATITUDE _____ ELLIPS. H

LONGITUTE _____ ERVERSE (X) ____

BASED ON THE FOLLOWING CONTROL:

♦ CORNER MONUMENT

O WITNESS MONUMENT

BEARINGS ARE BASED ON:

(a)

			_
FIELD BOOKPAGE #	SHEET	OF	
SHOW A PLAN VIEW DRAWING DEPICTING THE CORNER MONUMENT AN	ND SURRO	UNDING	
PHYSICAL FEATURES, INCLUDING THE EXCAVATION AREA AND DEPTH.			
PLANNING & ZONING COMMITTEE ADOPTED THE ABOVE FORM ON 12/2/1982			

CE562

- (B) Describe any record evidence, monument evidence, occupational evidence, testimonial evidence or any other material evidence you considered, and whether the monument was found or placed.
- considered, and whether the monument was found or placed.
 1833 HARRISON ORIGINAL SURVEYOR 2640 TO SE COR & 2521.86 TO SW COR.
- 1863 LOCKE VOL 1 PG 180 SET LIMESTONE 14X7X6. 2537.04 VAR 7-50 TO SW COR SEC 18, 2655.84 VAR 7-50 TO SE COR SEC 18, 1327.92 TO S 1/16TH COR OF SW 1/4 SEC 18 WHERE HE SET SANDSTONE 14X8X9, 2666.4 TO CENTER OF SEC 19, & 5332.8 TO S 1/4 COR SEC 19.
- 1863 LOCKE VOL 1 PG 181 SET LIMESTONE 14X7X6. 2653.2 TO CENTER OF SEC 18, 5306.4 TO N 1/4 COR SEC 18, 2537.04 TO SW COR SEC 18.
- 1976 BARNES VOL 5 PG 230 SAME INFORMATION AS IN VOL 5 PG 559.
- 1979 BARNES VOL 5 PG 559 CALLS FOR 1332 TO N/S FENCE AT S 1/16TH OF SE 1/4 SEC 18 & 2664 TO SE COR SEC 18.


DUG LARGE HOLE 5.5' DEEP AS SHOWN ON THE DRAWING. ABOUT 3-4' DEEP FOUND PIECE OF GLASS AND PIECE OF METAL. HOLE VOID OF STONES AND OTHER MATERIALS. LOCKE'S 1863 INDICATES THAT HE ESTABLISHED THE CORNER AT SINGLE PROPORTIONATE DISTANCE WITH HARRISON'S ORIGINAL RECORD DISTANCE. ESTABLISHED CORNER ON LINE WITH SW & SE CORNERS OF SEC 18 AT PROPORTIONATE DISTANCE WITH LOCKE'S RECORD DISTANCES. THIS WAS IN HARMONY WITH OCCUPATION LINES AS SHOWN IN 1976 BY ME AND THE FENCE INTERSECTION AT THE CENTER OF SECTION 18.

- C) Was the corner restored through acceptance of (1) an obliterated evidence location, or, (2) a found perpetuated location?
 RESTORED CORNER THROUGH ACCEPTANCE OF OBLITERATED EVIDENCE LOCATION FROM LOCKE'S SURVEY WHICH WAS SUPPORTED BY OCCUPATION LINES.
- D) Describe any material discrepancy between the location of the corner as restored or reestablished and the location of that corner as previously restored or reestablished by distance and direction. Show the discrepancy on the plan view drawing under (a), above. Show the distances between the corner as previously restored or reestablished and (1) the corner as restored or reestablished, and (2) to at least 4 of the witness monuments shown on the drawing in (a), above.
- (E) Was the corner reestablished through lost corner proportionate methods? If so, show the method, including the directions and distances to other public land survey corners used as evidence or used for proportioning the corner location.

I, Donald Barnes, hereby certify that the corner location as identified by the corner code index was determined by me under by direction and control and that this U.S. Public Land Survey Monument Record is correct and complete to the best of my knowledge and belief.

Ponald Baines Oct 3, 1996

Number of included sheets ___

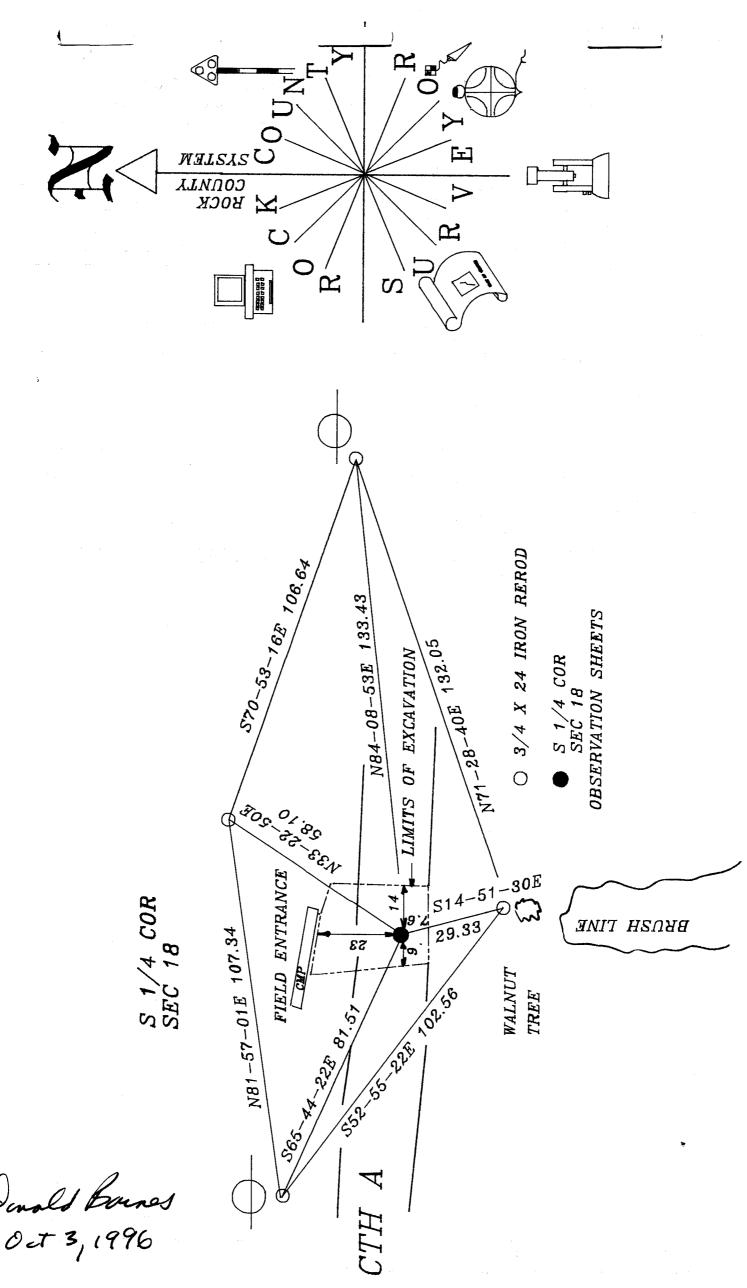

Oct 7 1996

